


LOTS 6, 7, 8, 9, 10 & 11.  
 CHAS. WEIDE'S SUB'N.  
 BLOCK 46  
 ARLINGTON HILLS ADD.

JOHN B. IRVINE, SURVEYOR.  
 408 GLOBE BLDG.  
 ST. PAUL, MINN.  
 NOV. 28-1913.

PAYNE AVE.

scale 10 ft. per inch.

ST. MAURICE ST.

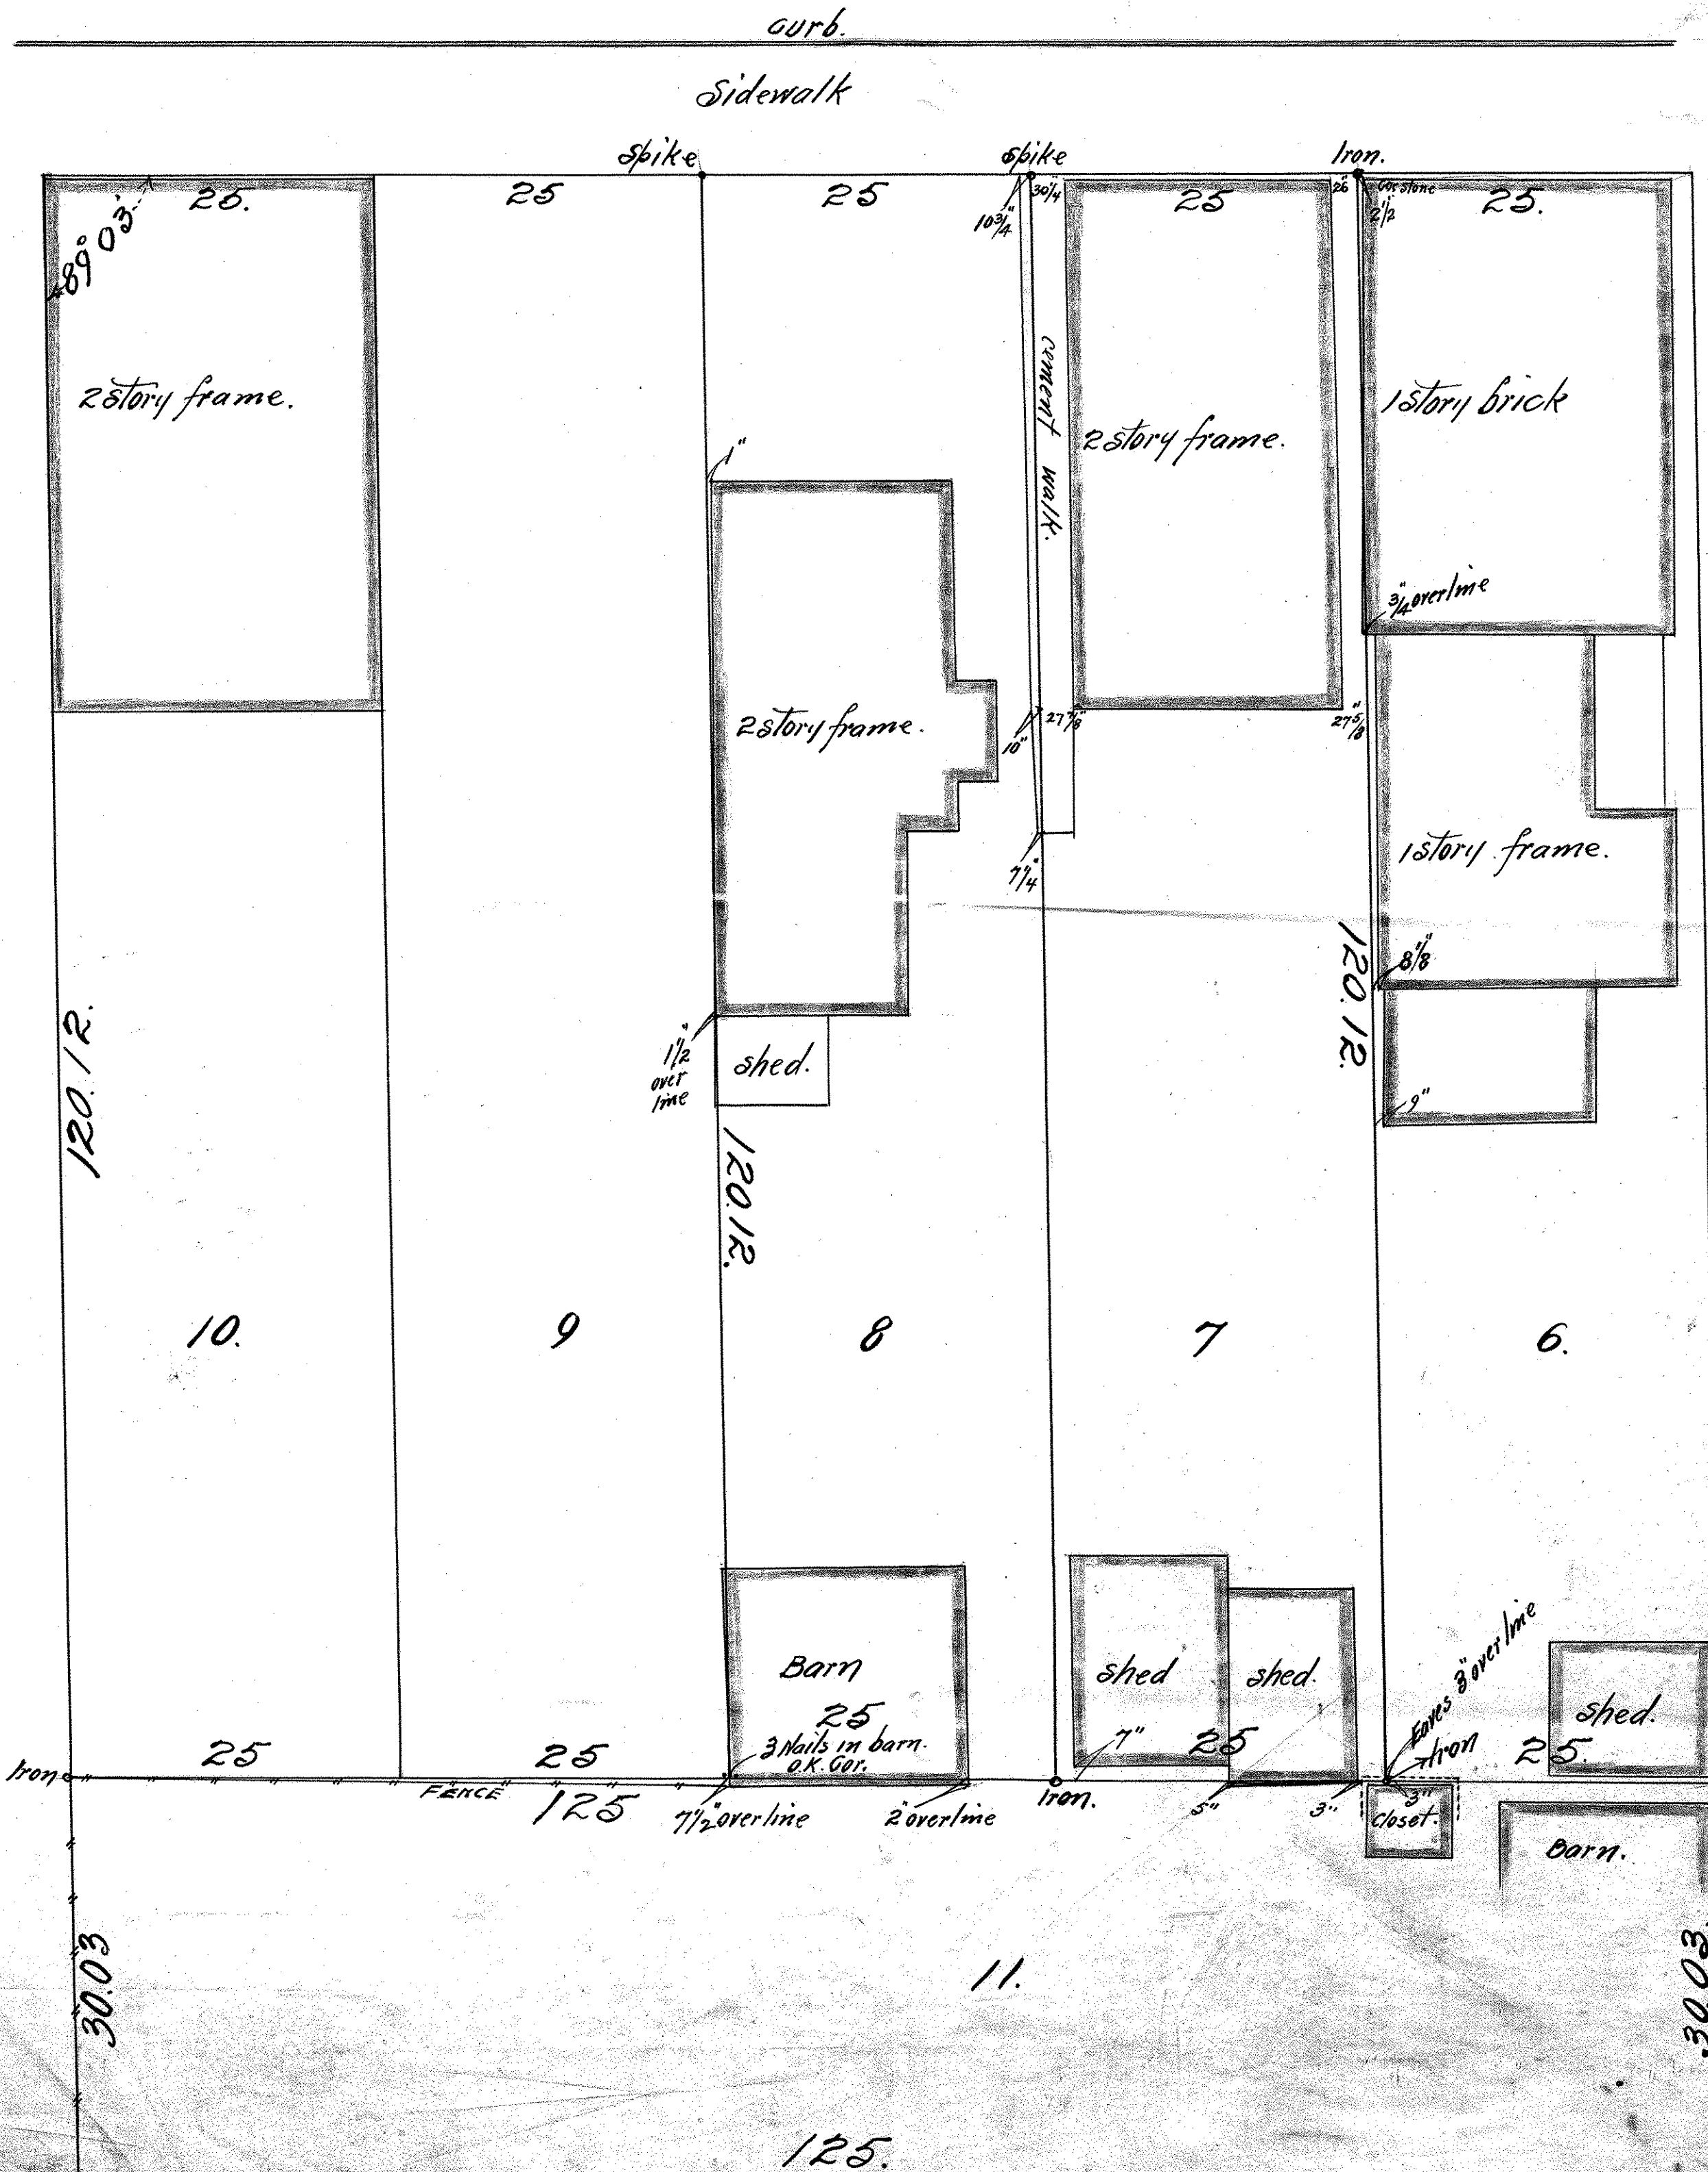

20ft. Alley.