


LOT 13 C.A. WEIDE'S SUB.
BLOCK 46
ARLINGTON HILLS ADD.

JOHN B. IRVINE, SURVEYOR.
ST PAUL MINN

SEPT. - 21, 1908.
SCALE 20 ft. per. inch.

SEPT. 1908.
WHITALL STS

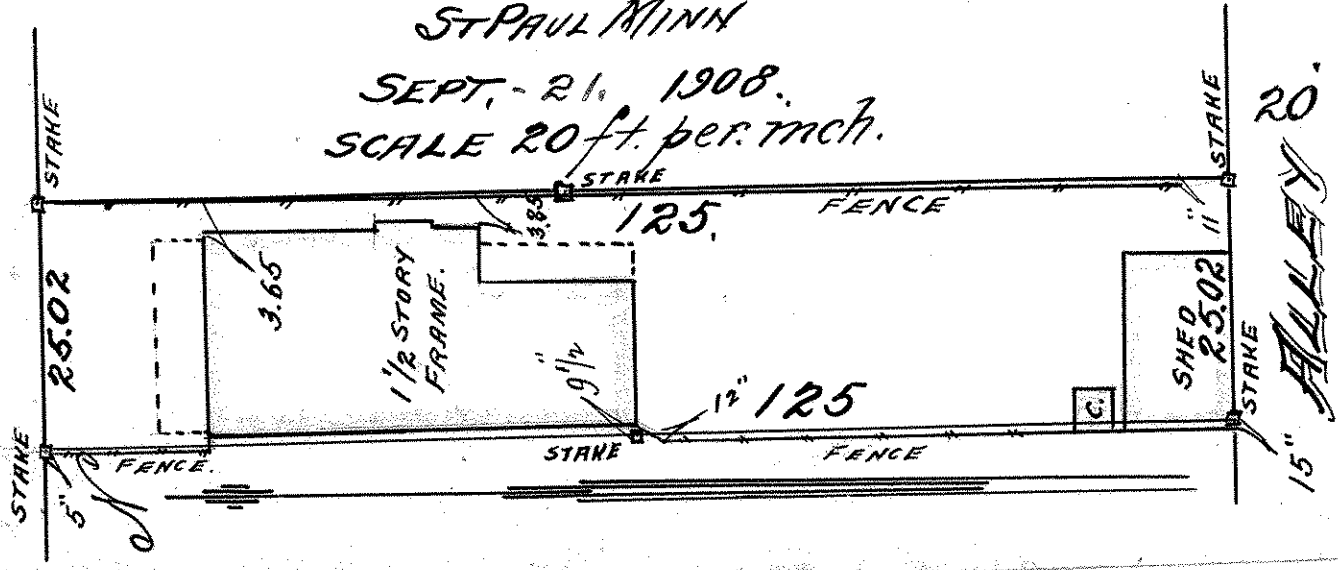

15" ALLEY 20'