LOT 7, BLK. 46.
C.A. WEIDE'S SUB.
ARLINGTON HILLS.

JOHN B. IRVINE SURVEYOR.
416 GLOBE BLDG.
ST. PAUL MINN.
SEPT. 18-07.
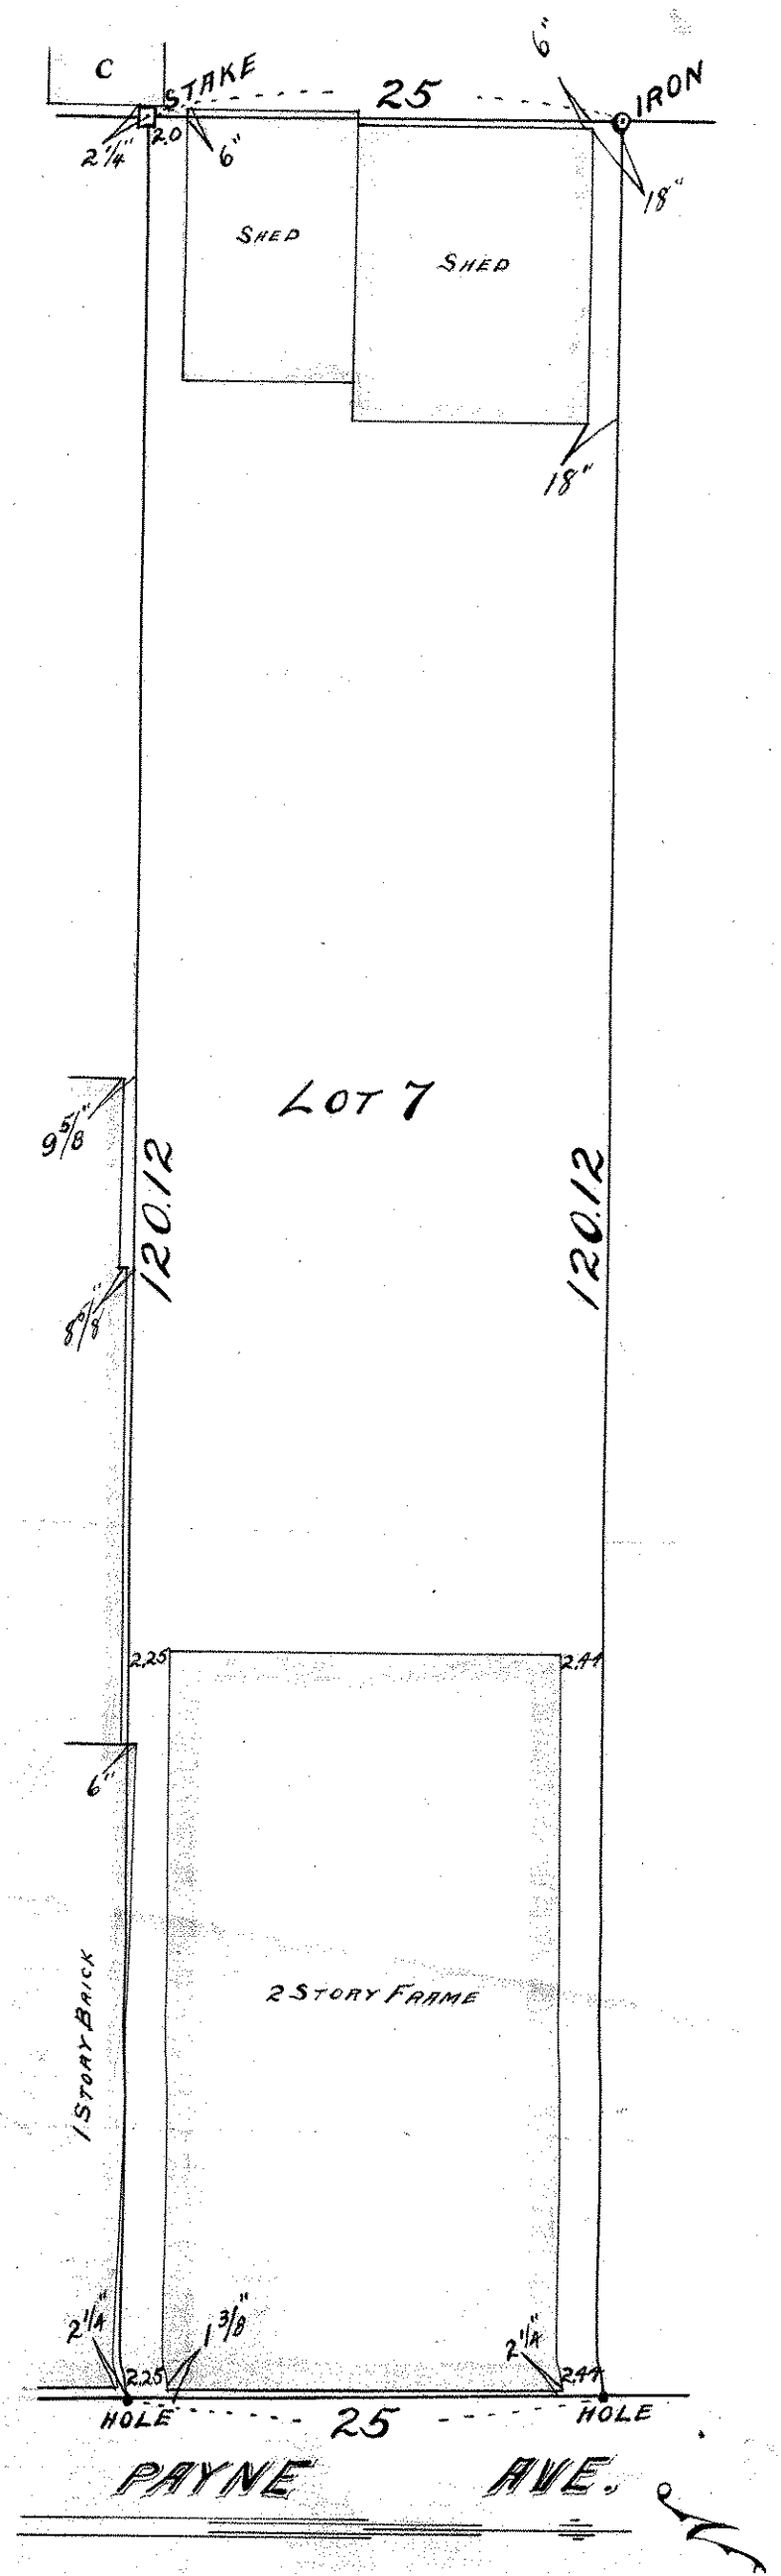
SCALE 10 ft. per inch.