


LOT 37 CHAS. WEIDES SUB OF.
BLKS 25 & 26 ARLINGTON HILLS ADD.

JOHN B. IRVINE SURVEYOR.
ROOM 508 GLOBE BLD'G.

SCALE 1 IN. = 20 FT.

ST PAUL MINN.

JUNE 8-05.

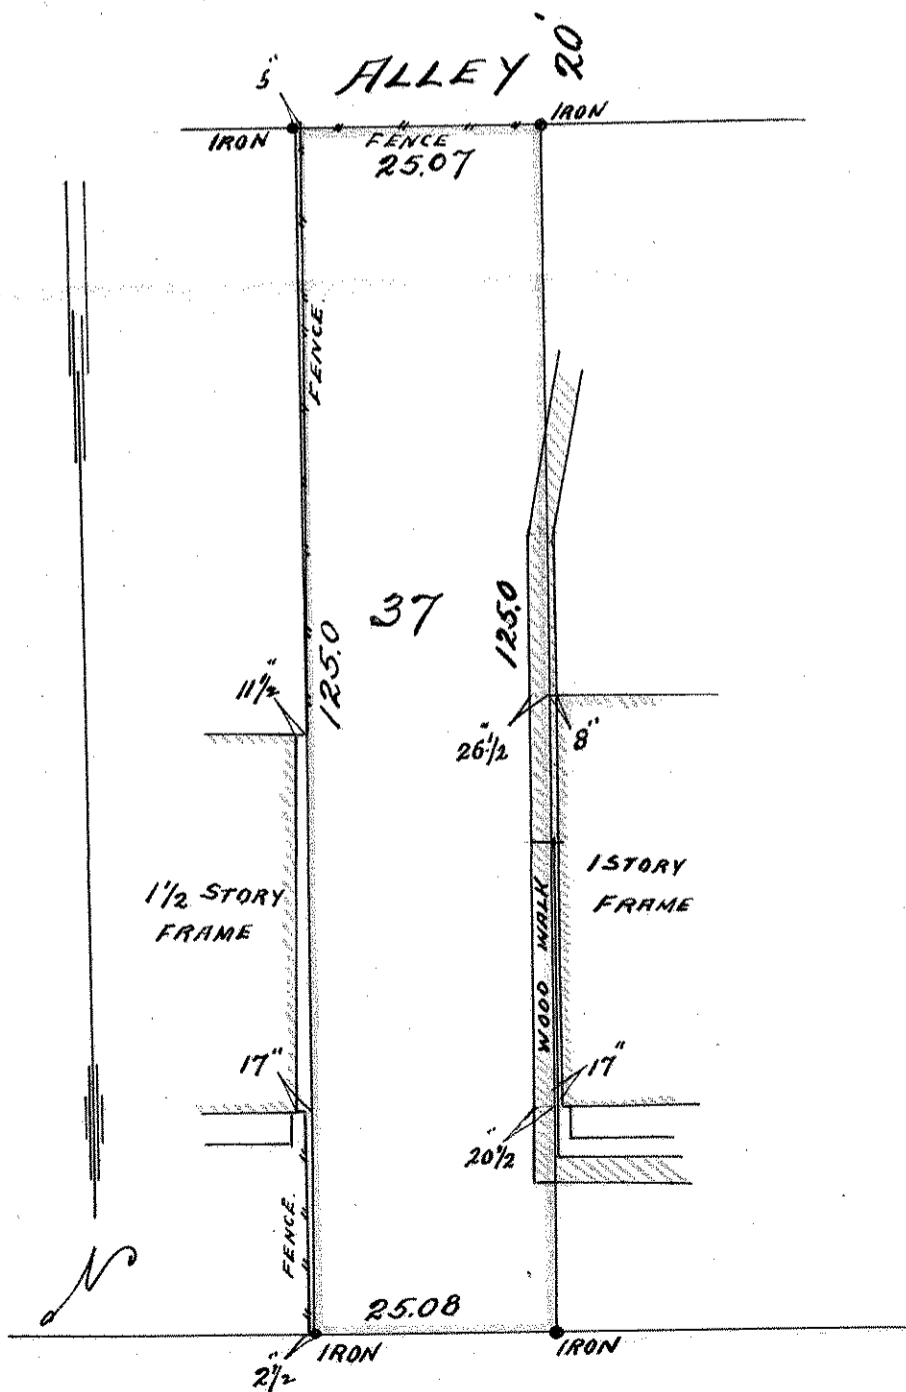

CASE ST.