
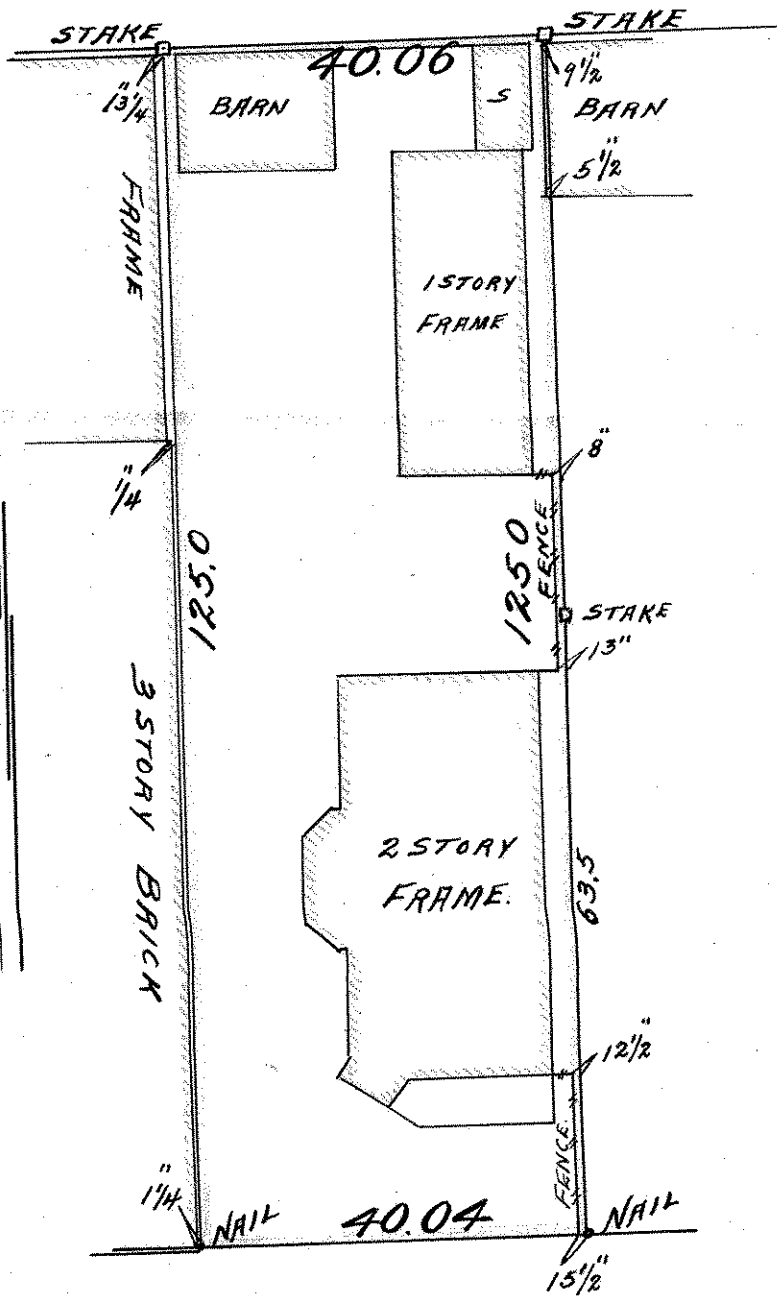


LOT 17 C. WEIDE'S SUB.
 BLK. 34 ARLINGTON HILLS ADD.

JOHN BIRVINE SURVEYOR.
 ROOM 508 GLOBE BLDG
 ST PAUL MINN.

JULY 17-05.

SCALE 1 IN. = 20 FT.

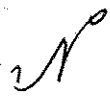

WELLS ST.