

MAY 1911

LOTS 2 & 3

JOS. R. WEIDE'S REAR

LOTS 29 & 30 BLK. 16.


ARLINGTON HILLS,  
ADDITION,

JOHN B. IRVINE, SURVEYOR.

408 GLOBE BLDG.

ST. PAUL, MINN.

MAY 2-1911.

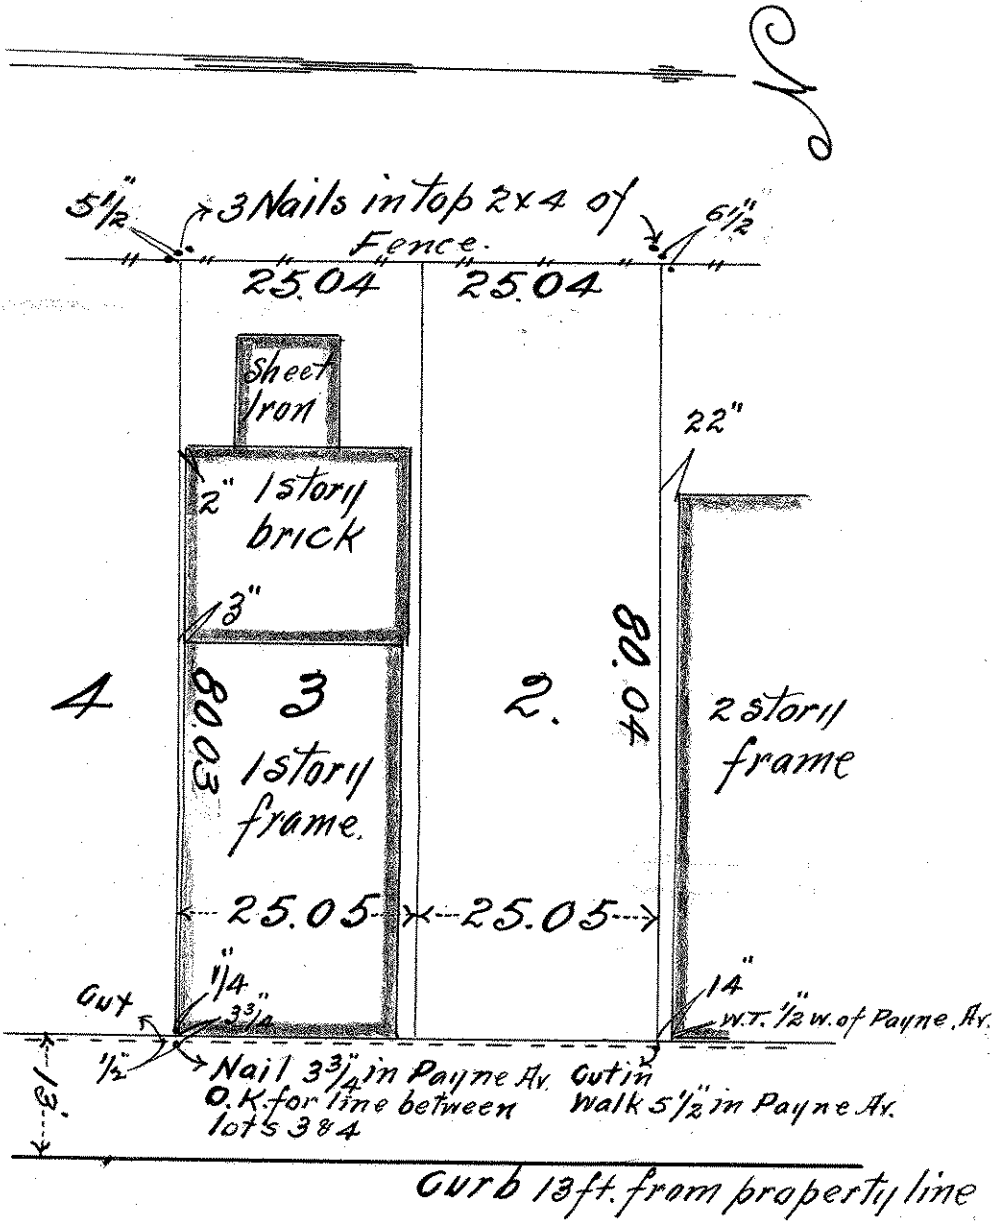

PAYNE AVE.