LOT 3 JOS. R. WEIDE'S RE. OF LOTS 29 & 30. BLK. 16
ARLINGTON HILL'S ADD.

JOHN B. IRVINE SURVEYOR

ROOM 508 GLOBE BLD'G

ST PAUL. MINN.

SCALE 10'=1"

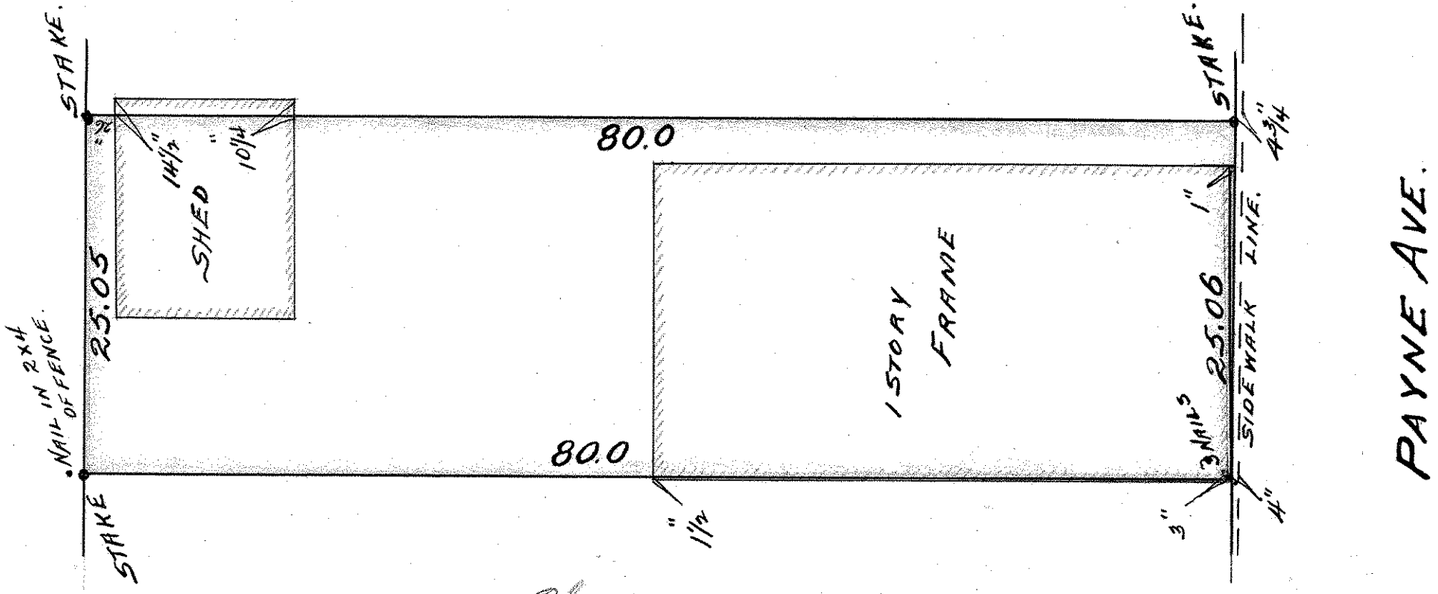

3/30/05