

LOT 21 BLOCK 1.

J. R. WEIDES

2ND ADD.


JOHN B. IRVINE, SURVEYOR.

ST PAUL, MINN.

APRIL 13-1908

SCALE 20 ft. per inch.

ALLEY, 20

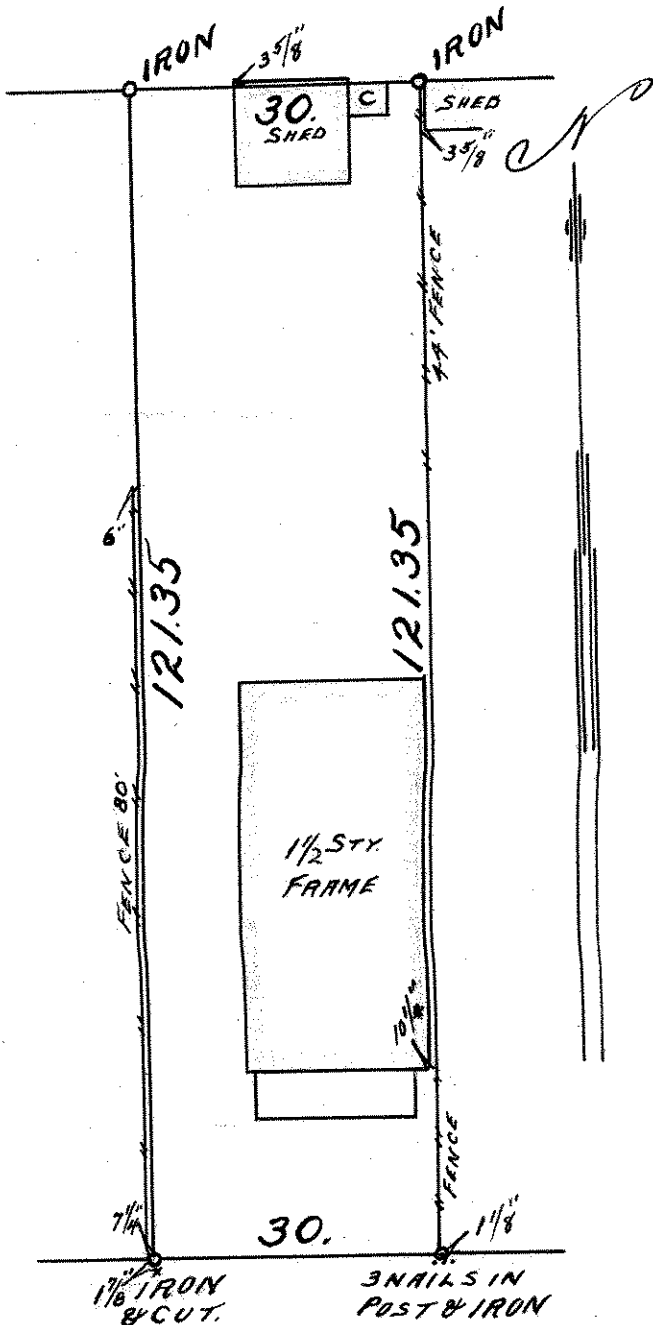

MARYLAND AVE.