


LOTS 41 & 42 BLOCK 2.

J. R. WEIDE'S 2ND ADD.

John B. Irvine, Surveyor.

April 19<sup>th</sup> 1921.

Scale. 20 ft. per. inch.

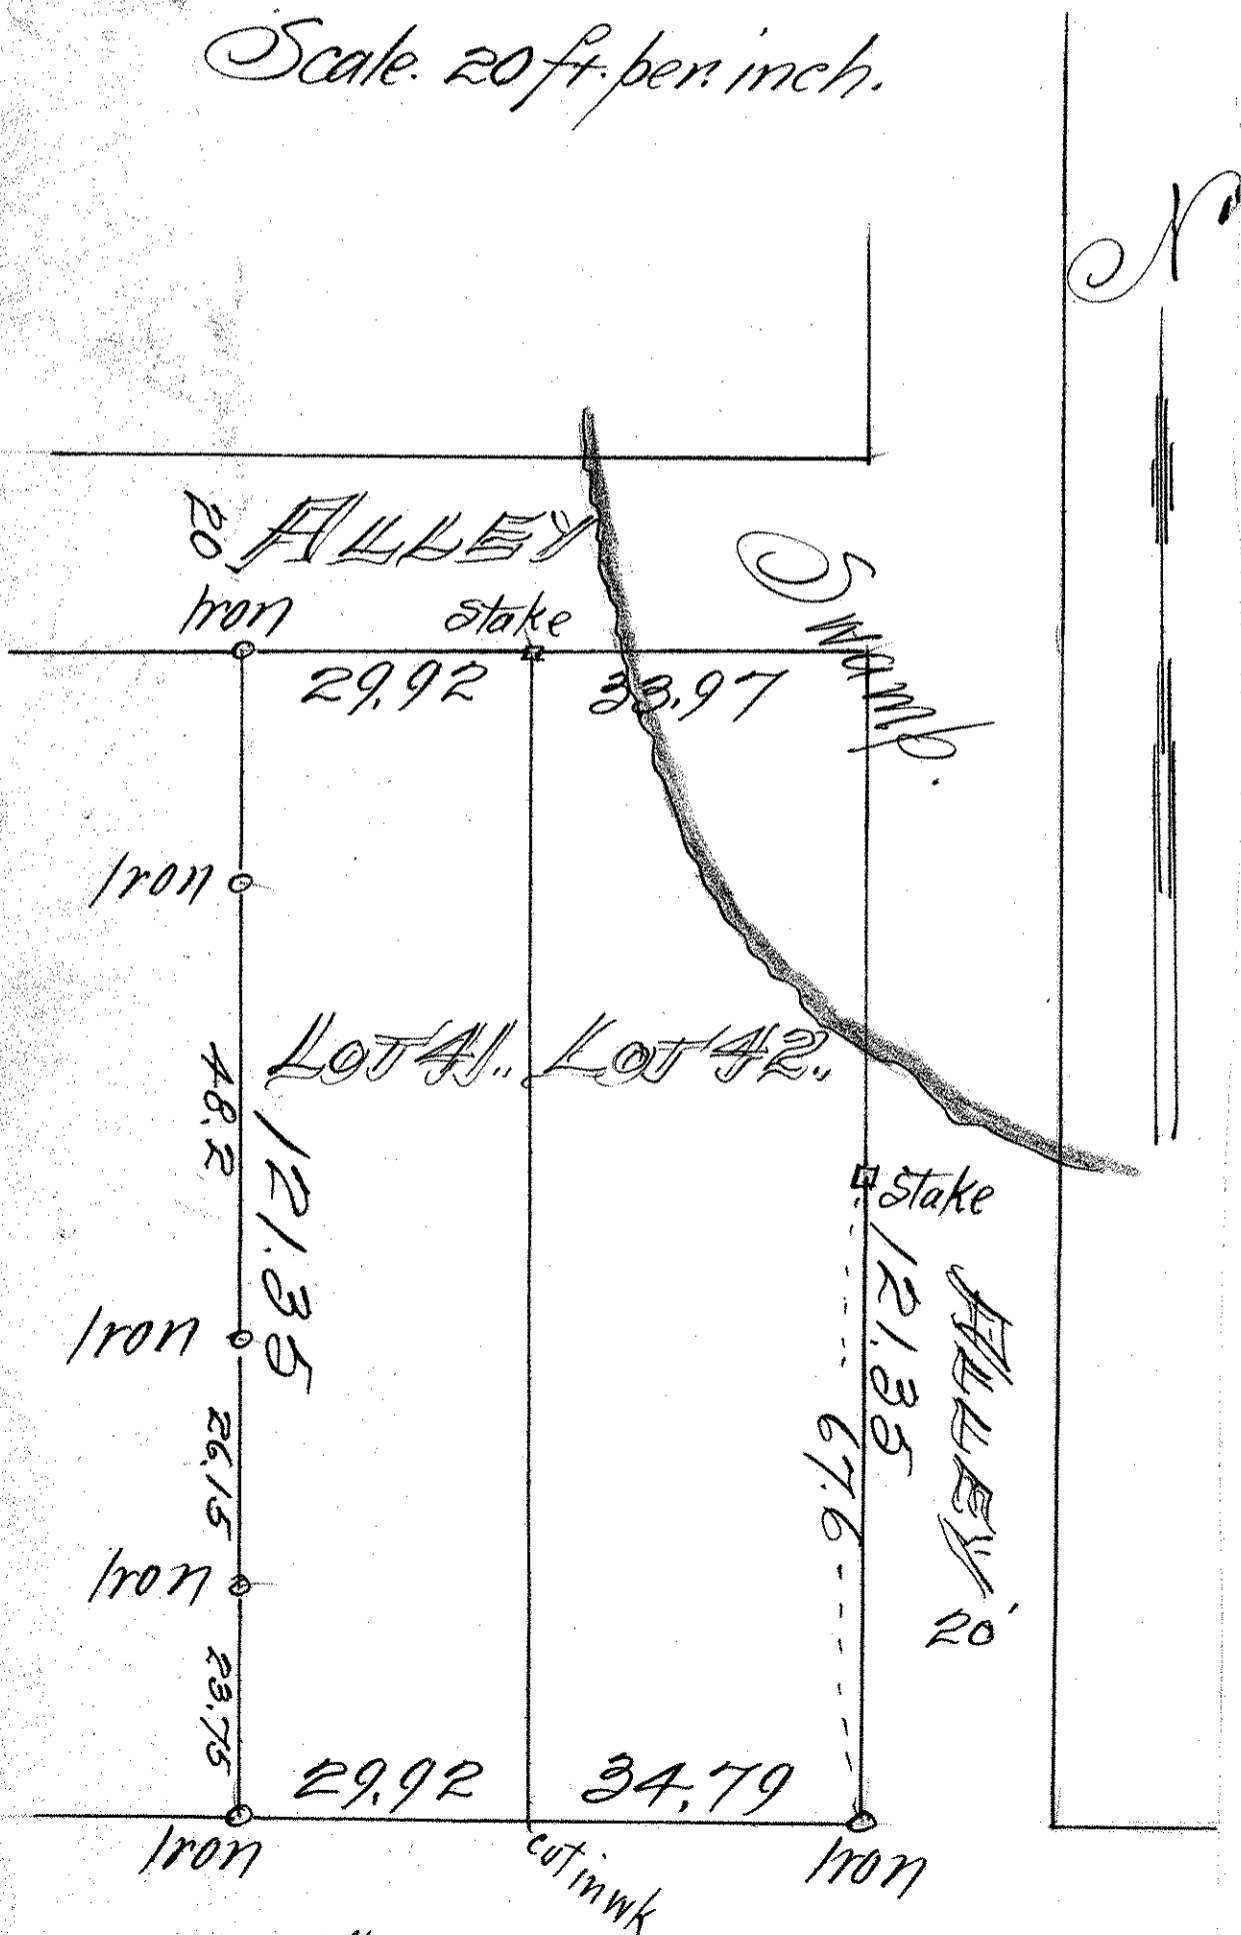

HAWTHORN ST.