


LOTS 1 & 2 BLOCK 1.
J. R. WEIÐE'S 2ND ADD.

No

JOHN B. IRVINE, SURVEYOR.
ST. PAUL MINN.
SCALE 20 ft. per inch.
OCT. 21-1908

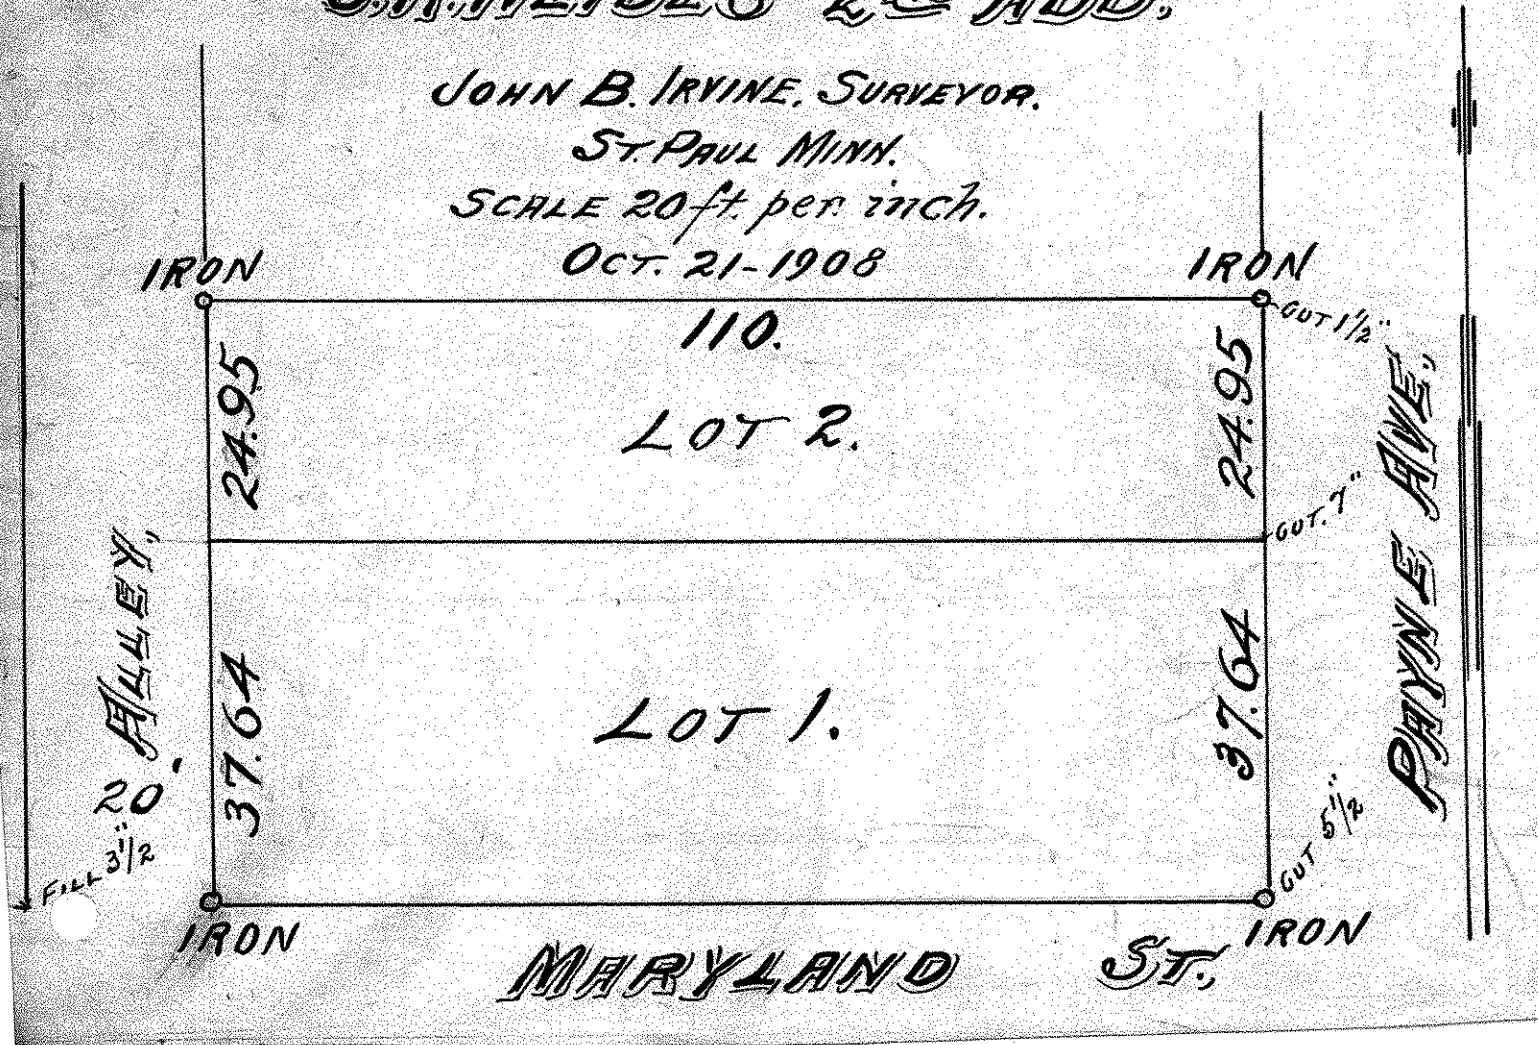

20' ALLEY,
FILL 3 1/2'

PAYNE AVE.

MARYLAND ST.

IRON

IRON

IRON

IRON

110.
LOT 2.
LOT 1.

GUT. 1 1/2"

GUT. 7"

GUT. 5 1/2"