

LOT 36 BLOCK 4

JOS R. WEIJDERS


2ND ADD.

John B. Irvine, Surveyor.

Sept. 30-1919.

Scale. 20ft. per. inch.

stake & ALLEY. iron.

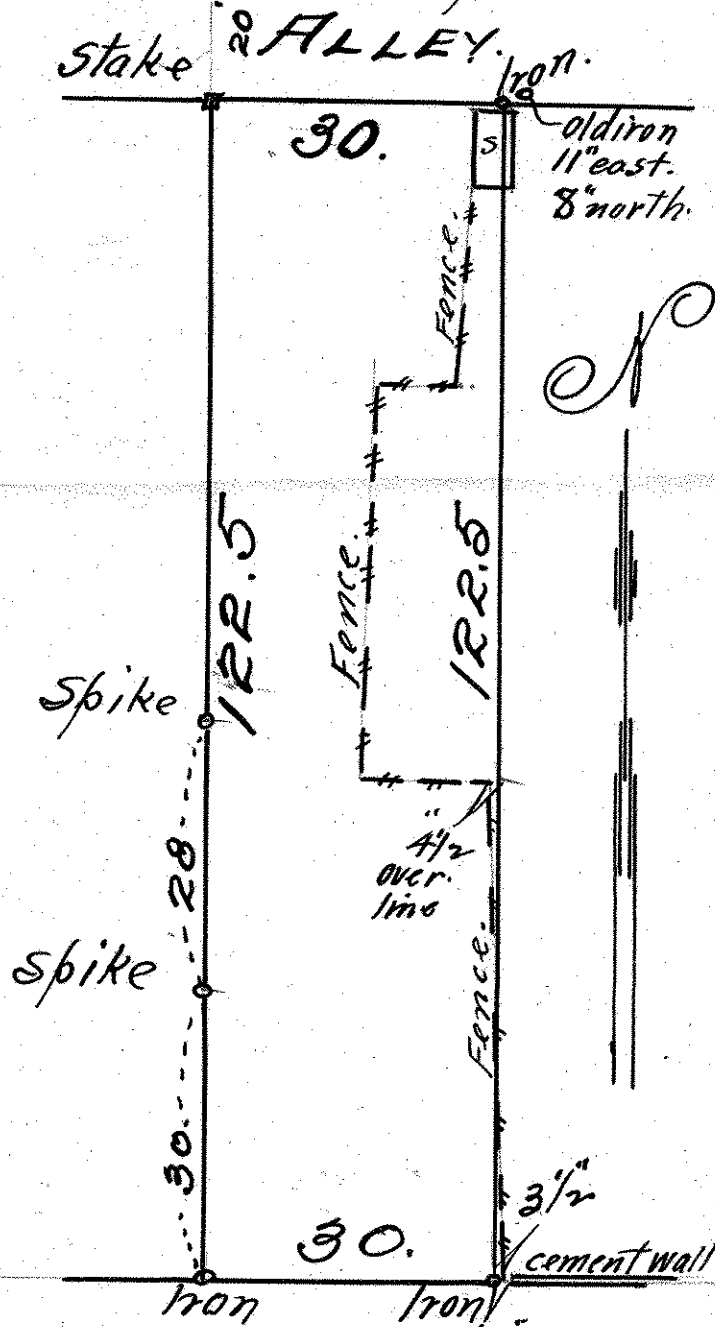

30.

old iron
11' east.
8' north.

Spike

122.5

Fence

122.5

Spike

28

4 1/2
over
1ms

Fence

30.

3 1/2
cement wall

Iron

Iron

HYACINTH ST.