

LOTS 1 & 2 BLOCK 1.
J. R. WEIDE'S 3RD


ADDITION.

JOHN B. IRVINE, SURVEYOR.

ST. PAUL, MINN.

MARCH 29-1911.

EDGERTON ST.

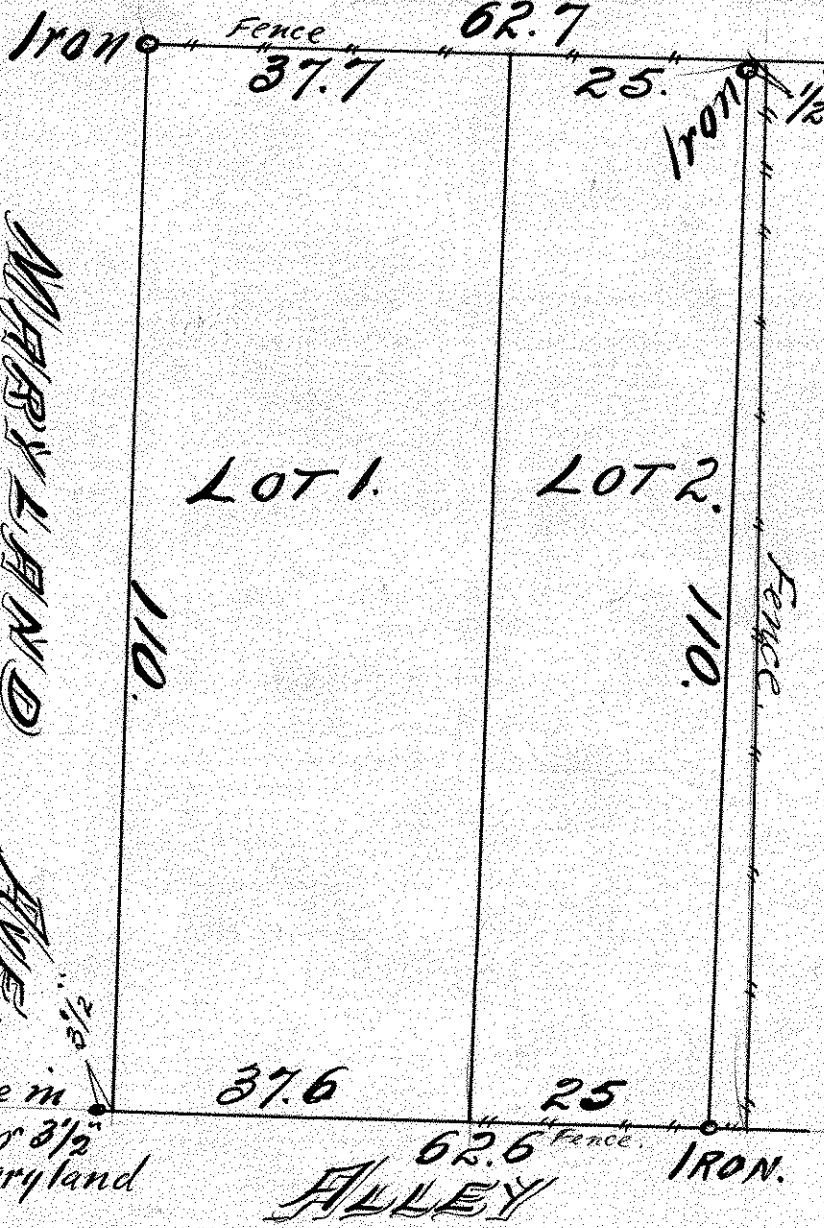

MARYLAND

ALLEY

Spike in header 3 1/2 in Maryland

ALLEY

IRON.