


LOT 20 BLOCK 2
J. R. WEIDE'S 4TH ADD.

scale 20 ft. pr inch
surveyed Sept. 2nd 1902

SEPT 1902

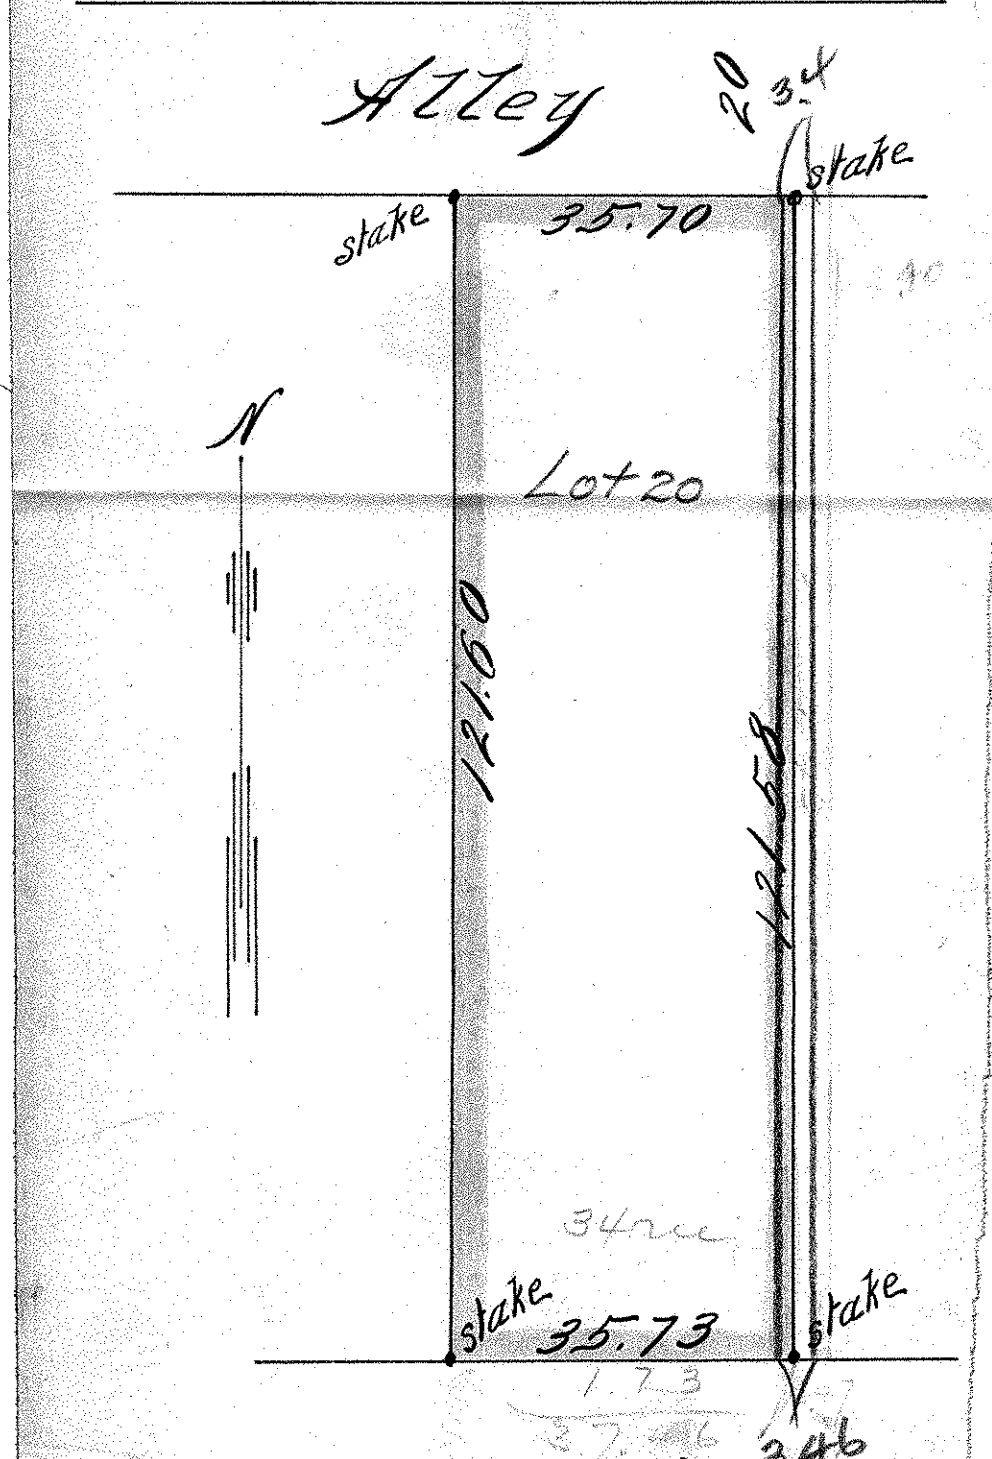

JESSAMINE ST.

B. 47 P. 71