


LOTS 16 & 17 BLOCK 1  
JOSEPH R. WEIDE'S 5<sup>TH</sup> ADD.

20' = 1"

Apr. 23 '04

• indicates Stake

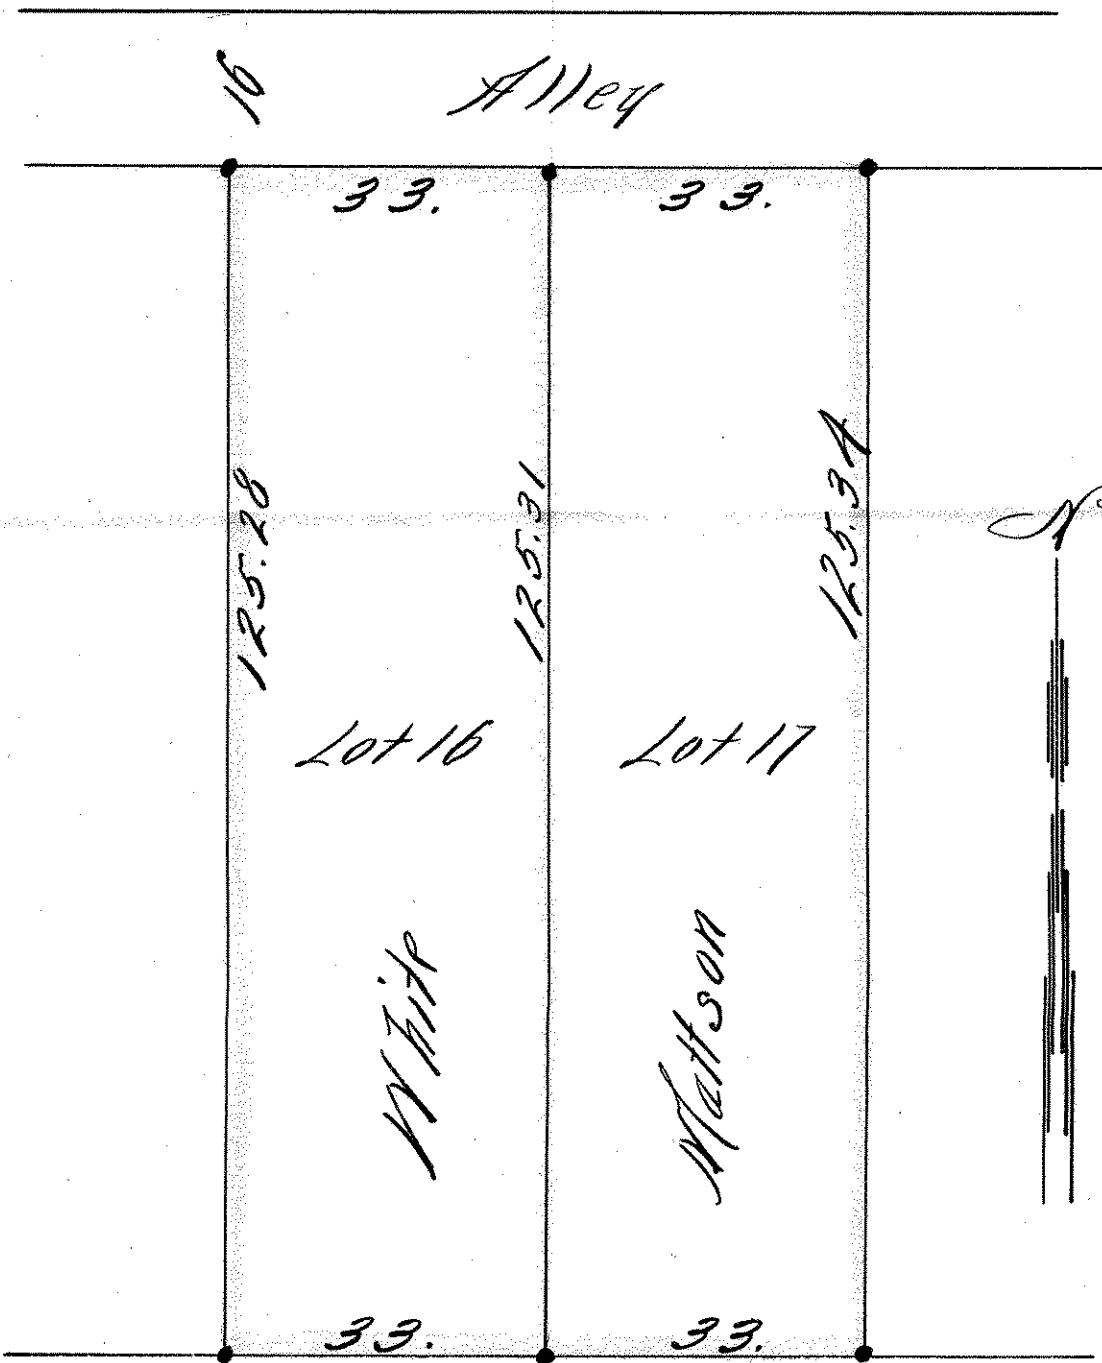

THOMAS ST.