

LOT 4
C. WEIDE'S SUB'D
BLOCK 37
ARLINGTON HILLS
ADDITION


JOHN B. IRVINE, SURVEYOR.

408 GLOBE BLDG.
ST. PAUL, MINN. N^o


APRIL-20th 1915

Scale 20 ft per inch.

WELLS ST.

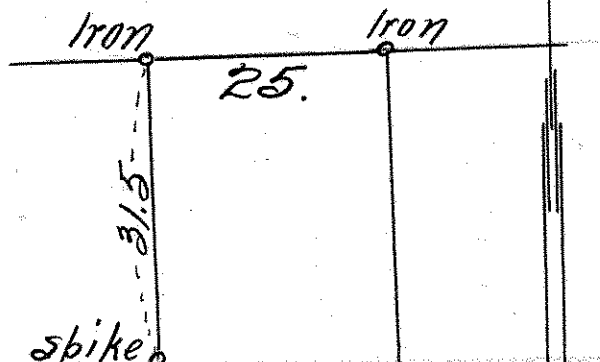

LOT 4

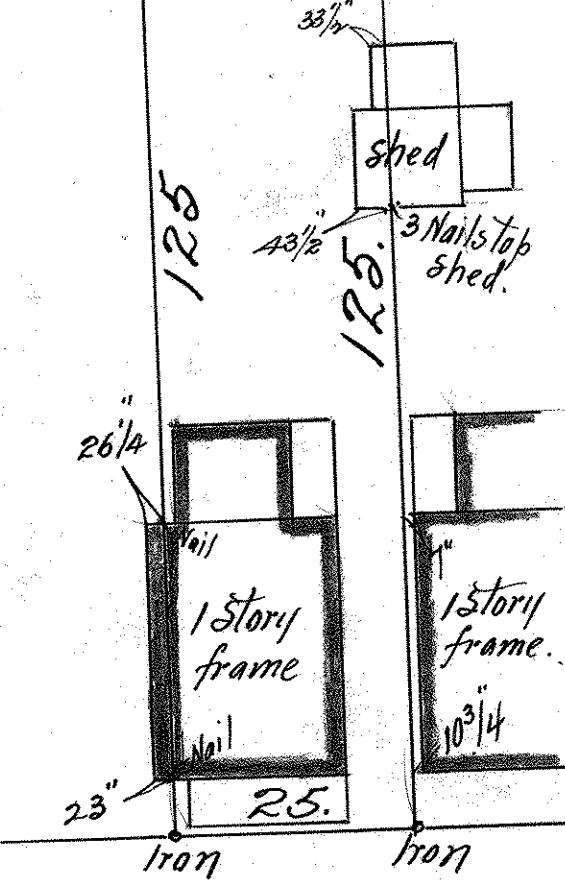

ARLINGTON ST.