


EAST 18.6 ft. LOT 26 & ALL OF  
LOTS 27, 28, 29 & 30

BLOCK 3

J. R. WEIDES REAR.

BLOCK 3 & N. 1/2 BLOCK 2.

WINTER'S ADD.

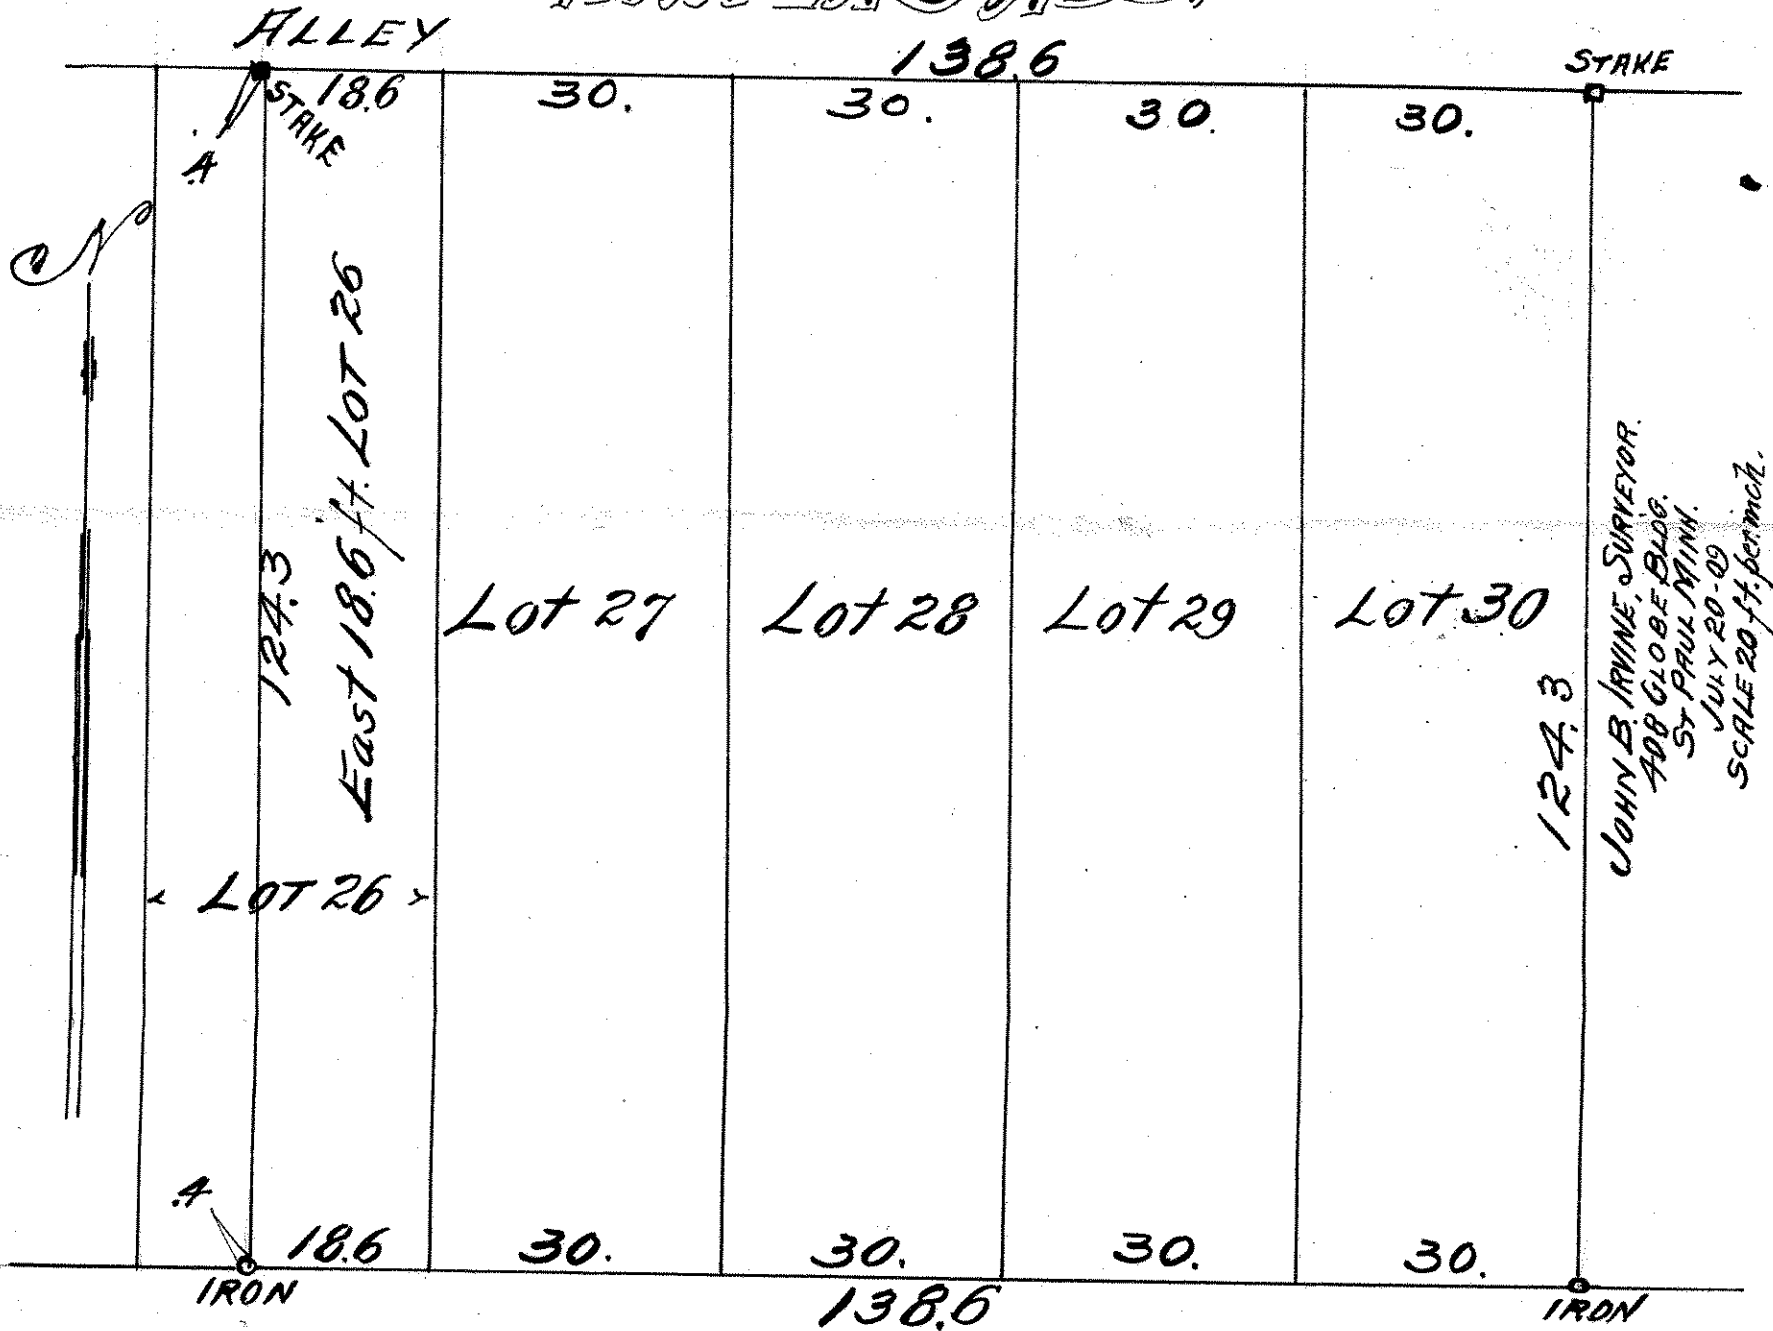

SEMINARY ST.