

LOT 21. & WEST $12\frac{6}{10}$ feet LOT 22

ALSO.

EAST $17\frac{4}{10}$ feet LOT 22 & WEST $22\frac{2}{10}$ feet LOT 23.

BLOCK 3.


J. R. WEIIDE'S RE-AR.

WINTERB'S ADD.

AUG 28-1913.
scale 20 ft. per. inch.

JOHN B. IRVINE, SURVEYOR.
408 GLOBE BLDG.
ST PAUL MINN

AVON ST.

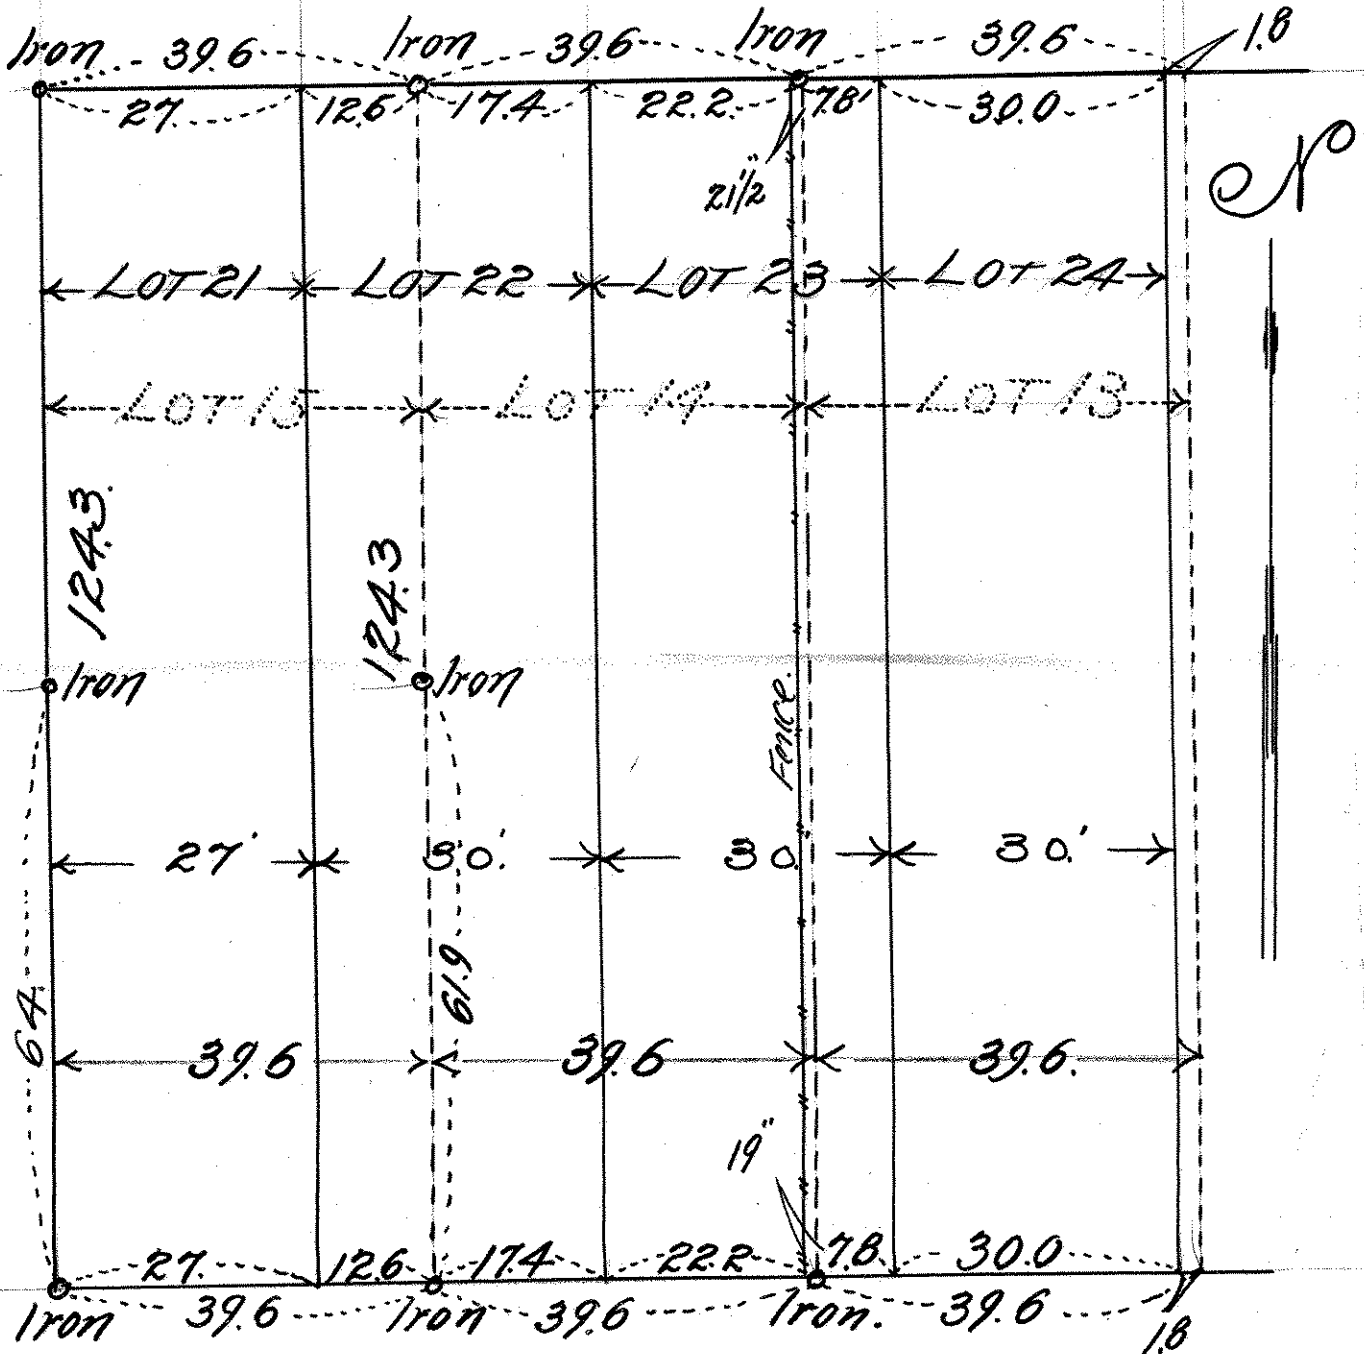

SEMINARY ST.