


LOT 16.
J.R. WEIDE'S
SUBDIVISION
BLOCK 24.
ARLINGTON
HILLS ADD.

JOHN B. IRVINE, SURVEYOR.
408 GLOBE BLDG.
ST. PAUL MINN.
OCT 25-09
SCALE 20ft. per inch.

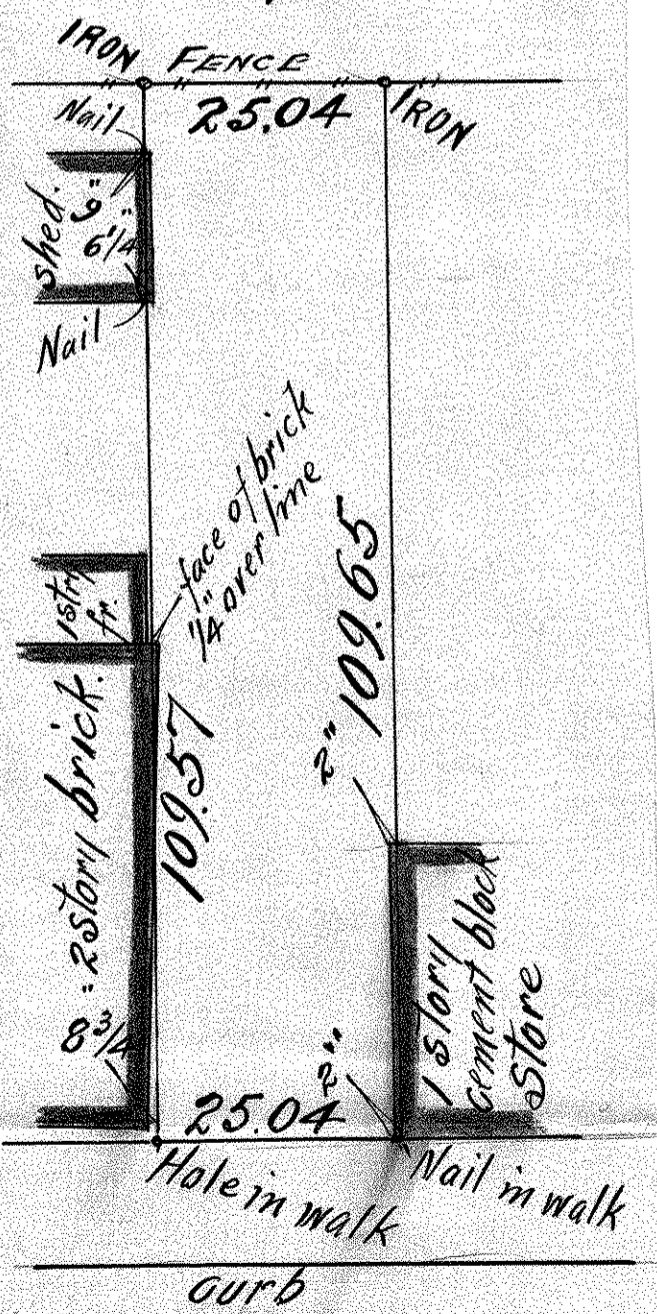

curb
PAYNE AVE.