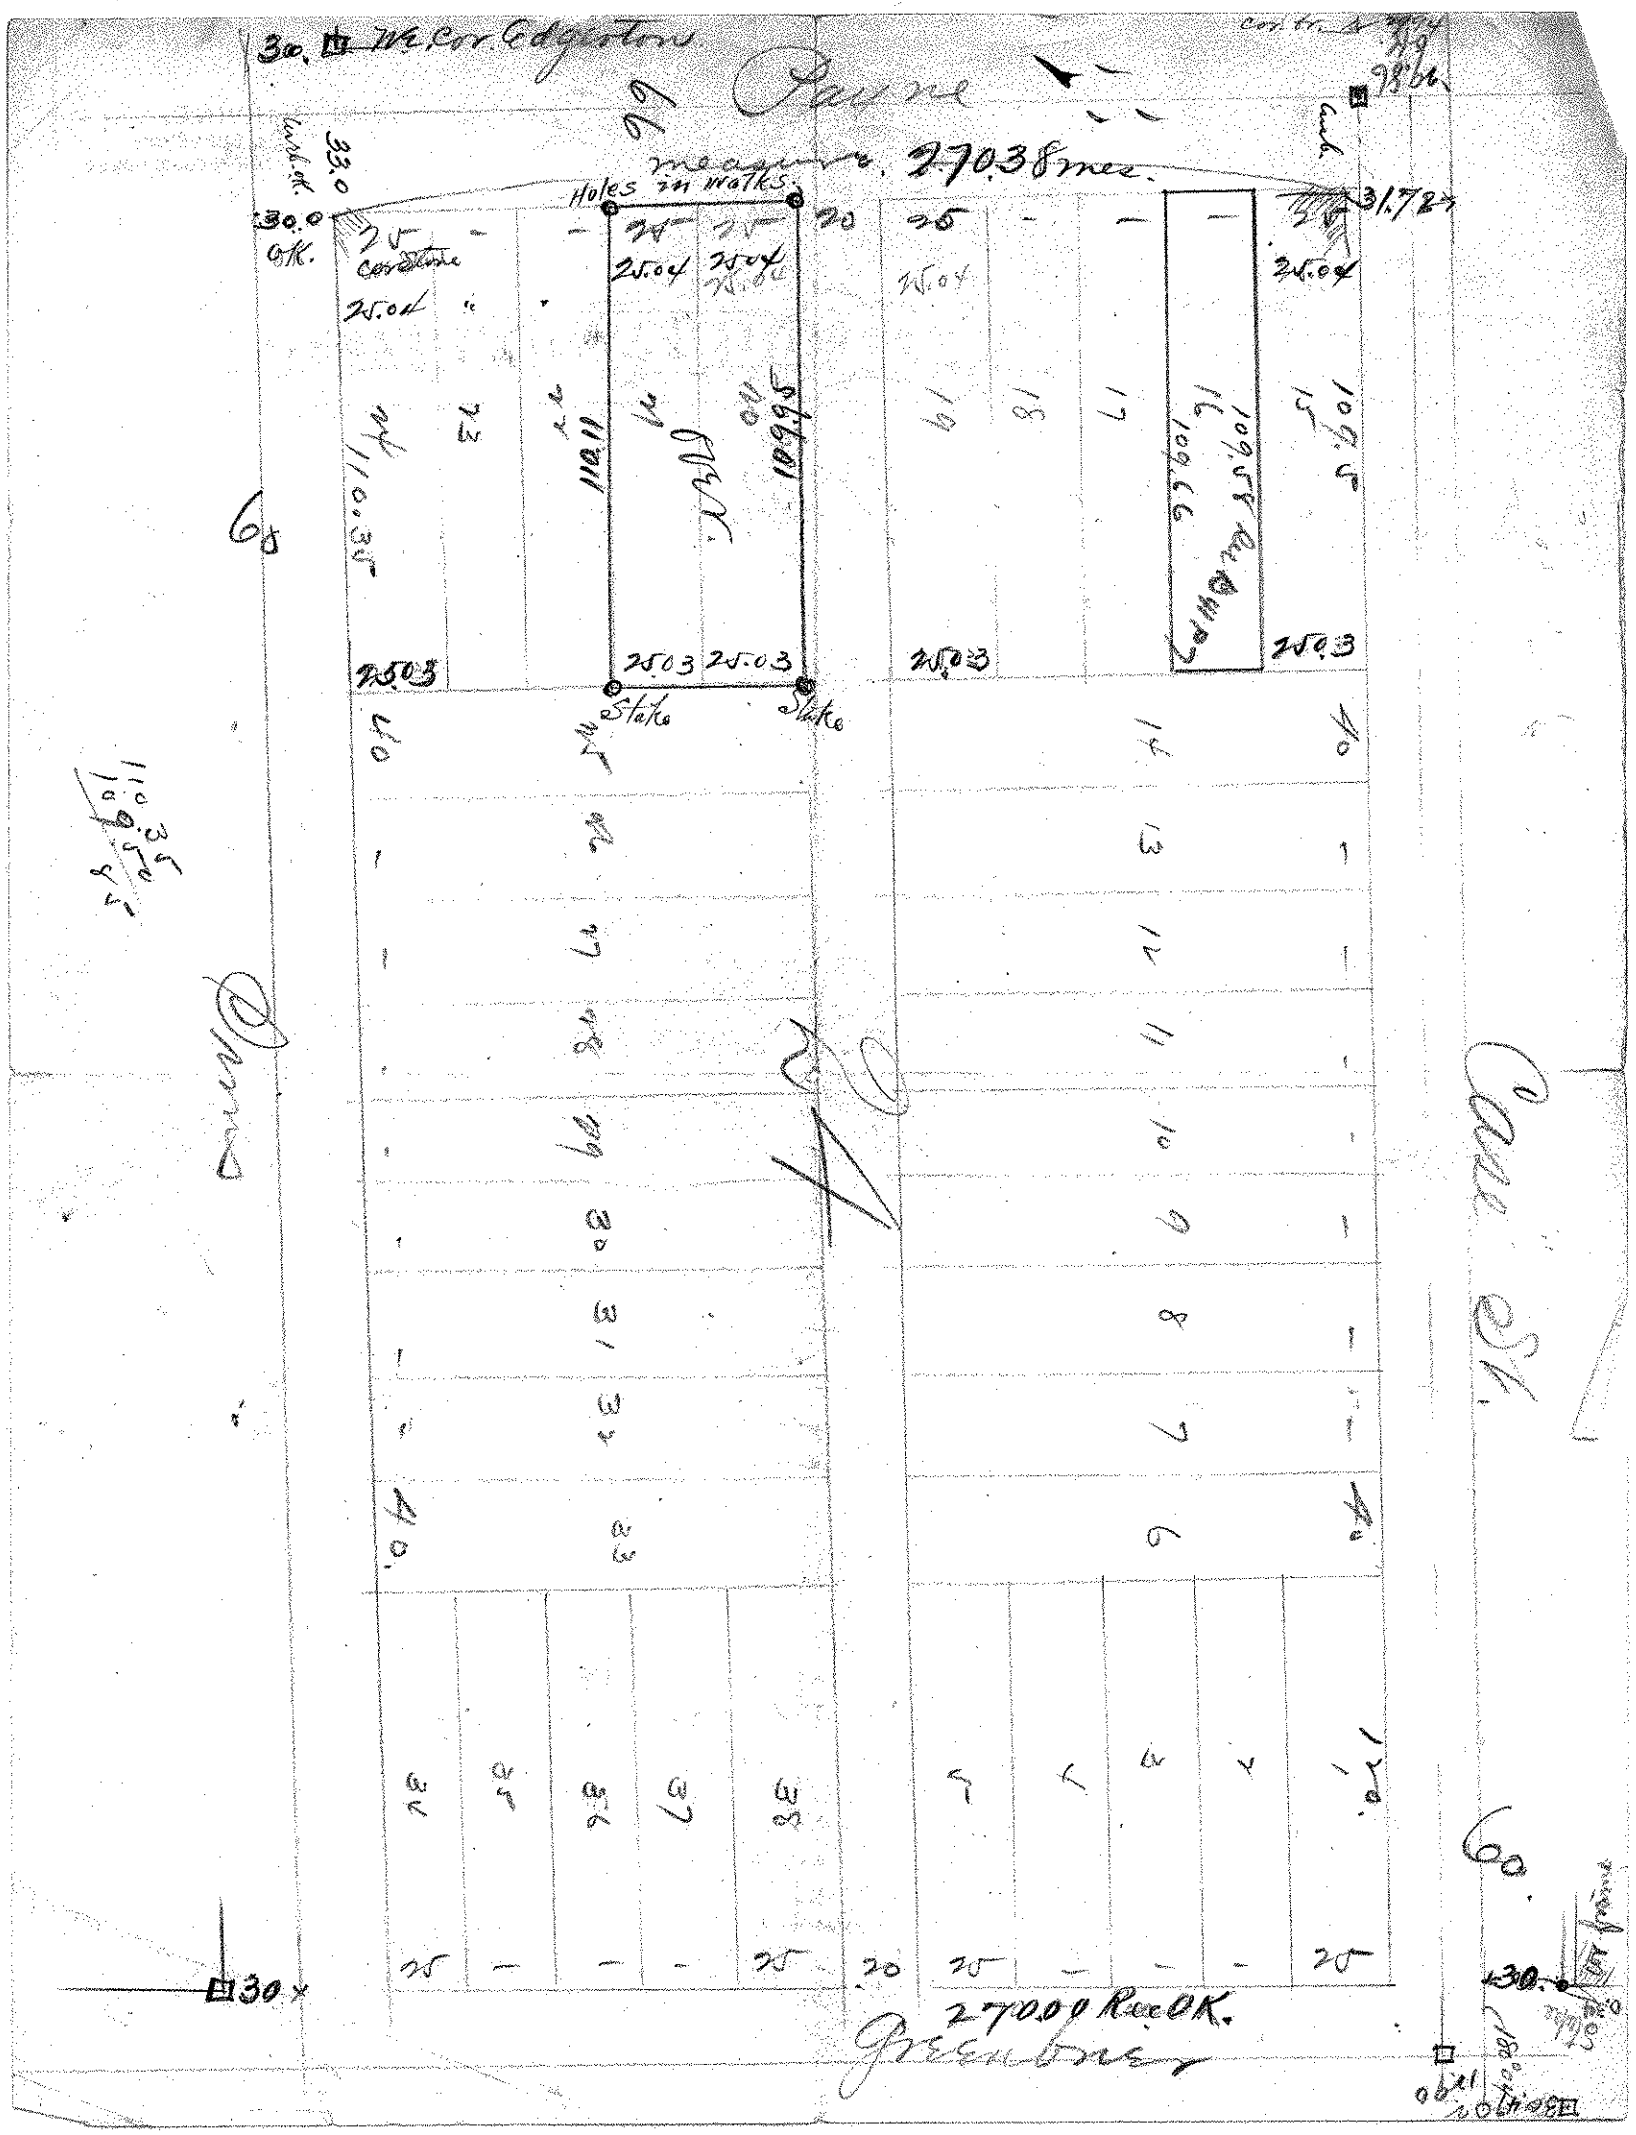

30. Wt. Cor. Edgerton
Payne
measure 27038 mes.
Holes in walks
Stake
Stake
Case St.
Greenbrier
27000 Rec OK.