


RAMSEY COUNTY  
OFFICE OF  
COUNTY SURVEYOR

JOHN B. IRVINE,  
SURVEYOR  
ROOM 16 COURT HOUSE.

St. Paul, Minn. 190

Edgerton

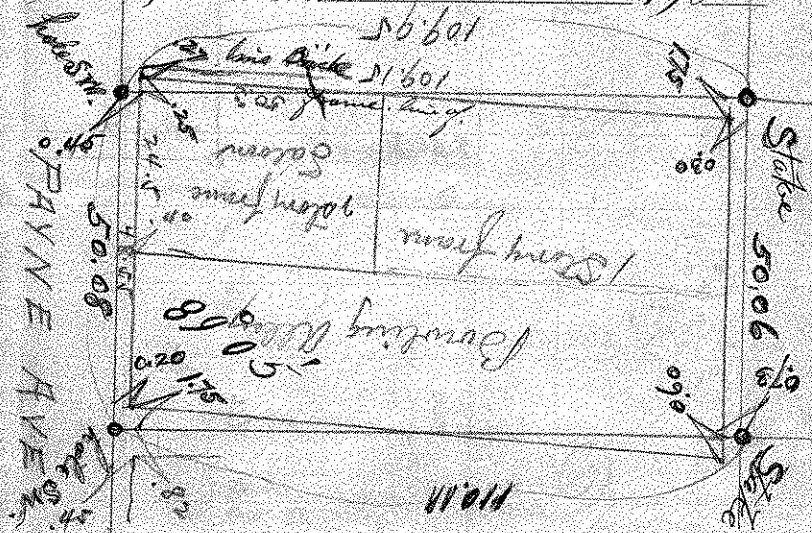

Payne

James

Case

Lots 20 - 21 - Blk 21  
J. R. Wicks Sub.  
Edgerton Hills  
Hanna Bros. Co.  
Oct. 25-03.

Leontine

See B. 41. P. 7.