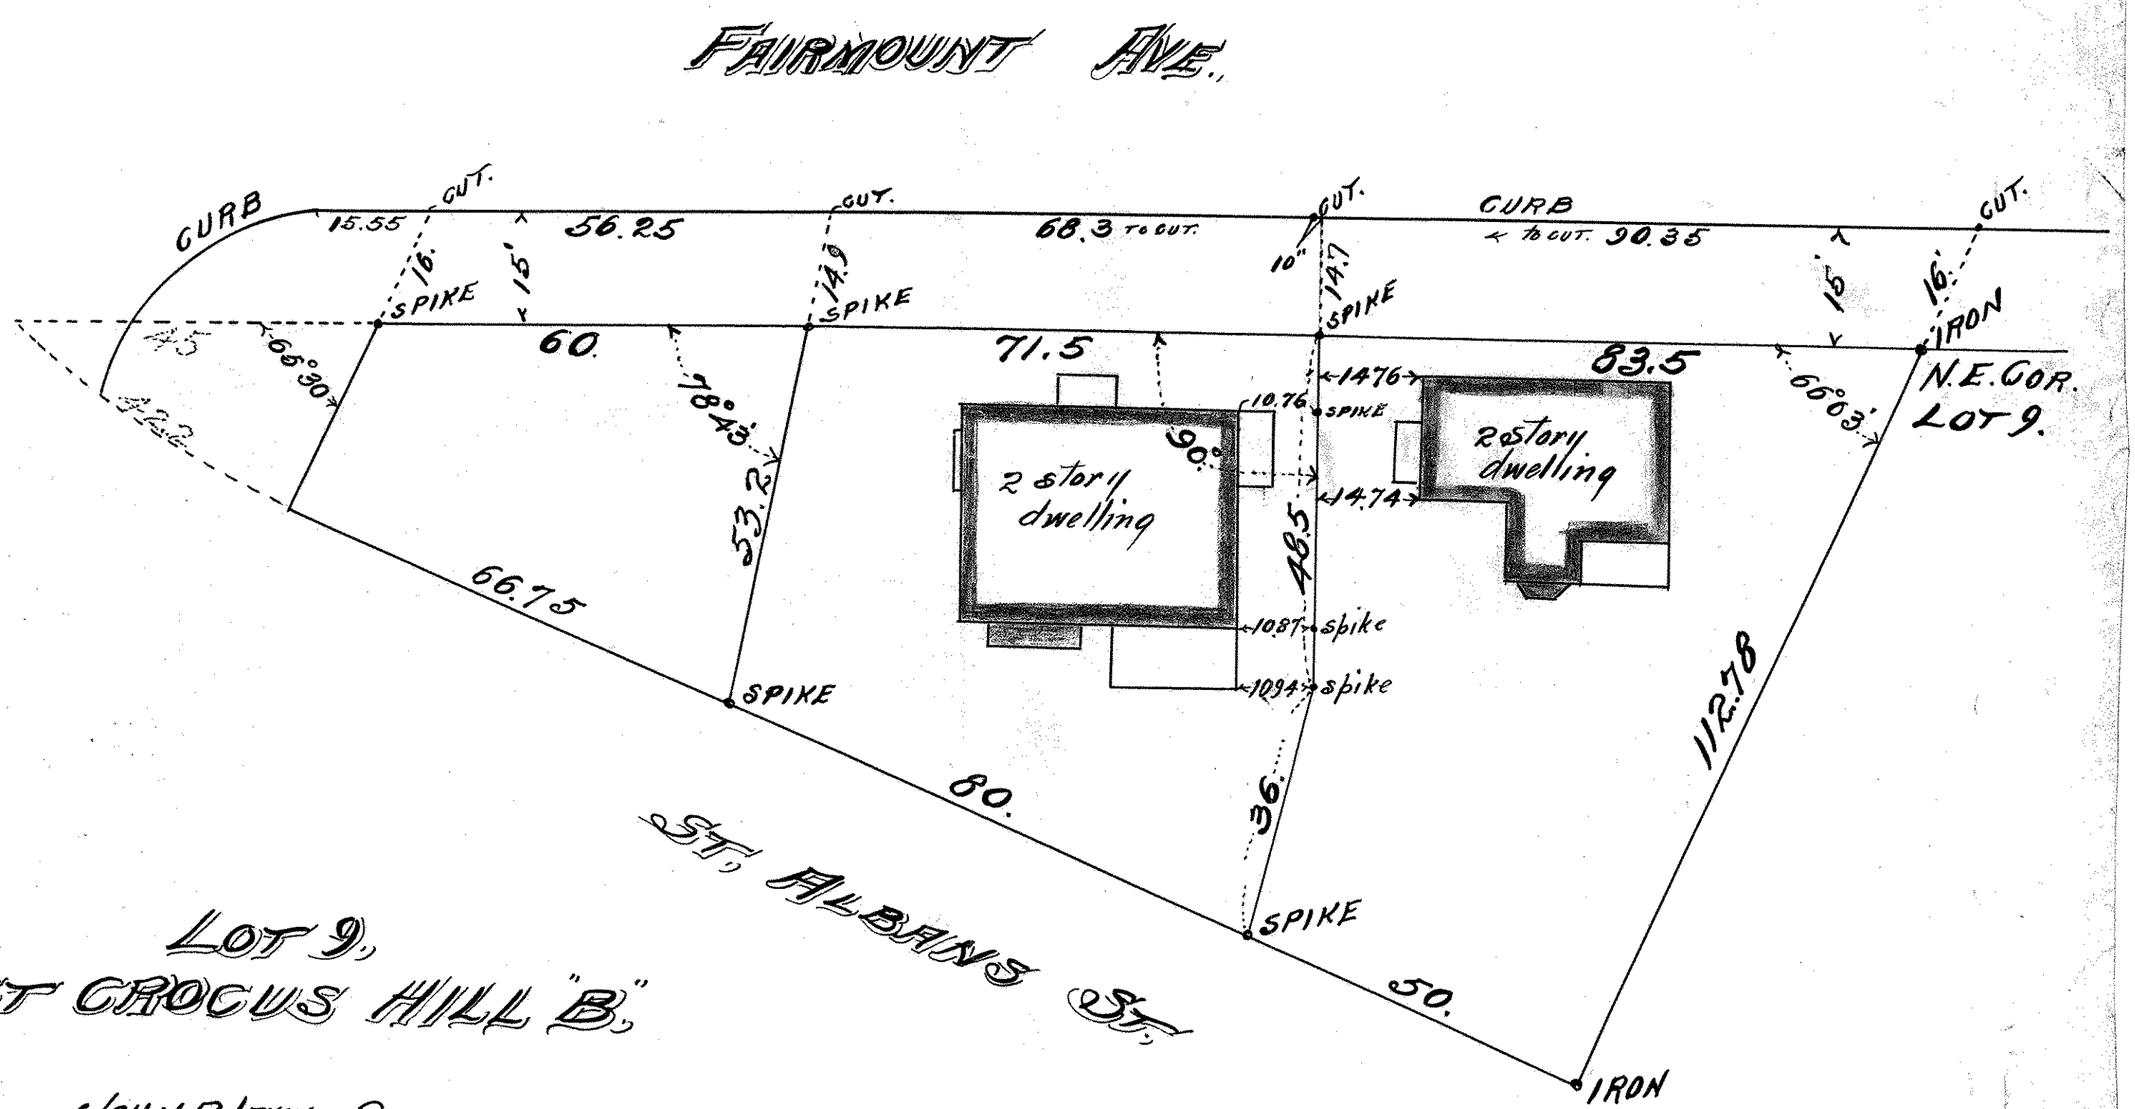

LOT 9, WEST CROCUS HILL "B."

JOHN B. IRVINE, SURVEYOR.
408 GLOBE BLD'G.
ST. PAUL, MINN.

MARCH 6-1911

SCALE 20 ft. per inch.