

LOT 18

WEST CROCUS HILL

JOHN B. IRVINE, SURVEYOR


ROOM 416 GLOBE BLDG.

ST PAUL MINN.

AUG. 21-06.

SCALE 1 IN. = 20 FT.

ALLEY 20.

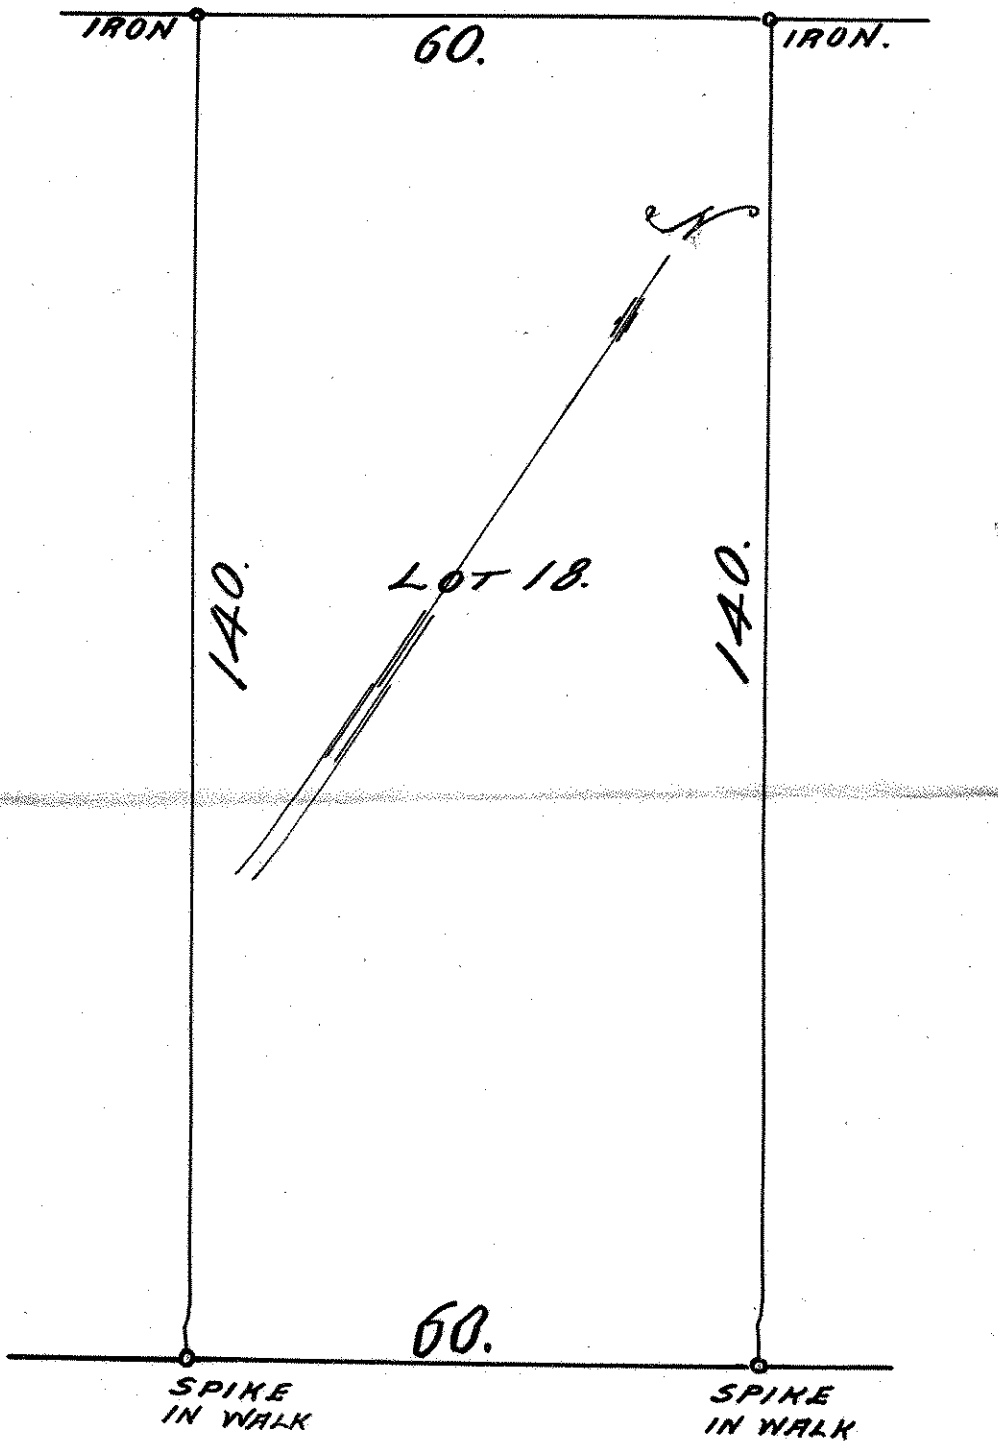

WEST CROCUS HILL