


LOTS 15 & 16 WEST CROCUS HILL

20 FT = 1 IN

SUR. May 7th '03 R.C. Night

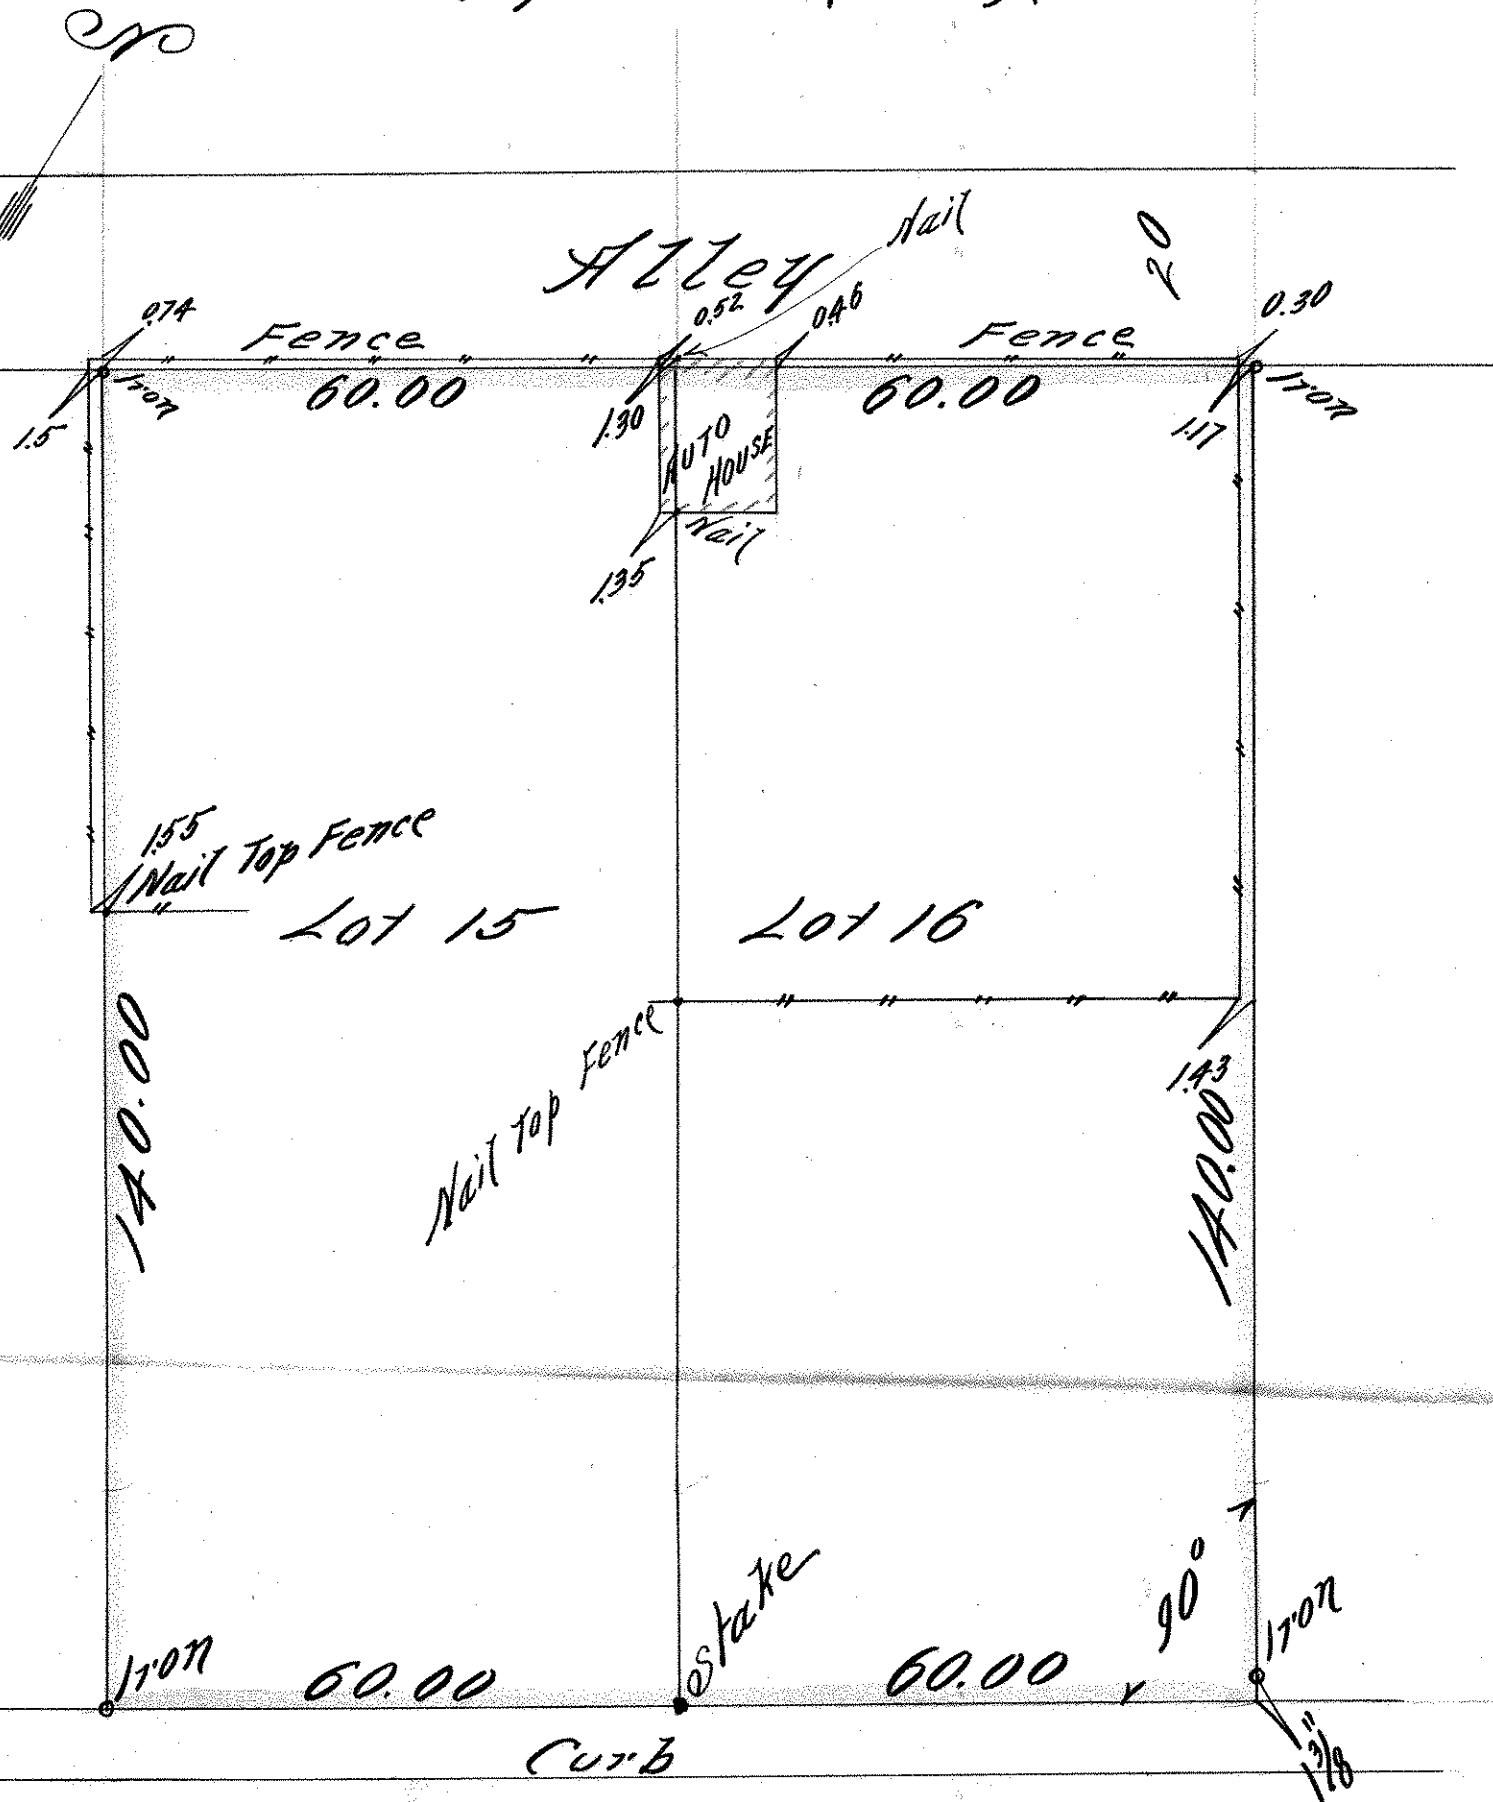

AA

CROCUS PLACE