


Top hydrant N.W. Cor. Fairmount & St. Albans St.  
 Elevation, 199.15 City Datum.

**FAIRMOUNT AVE.**

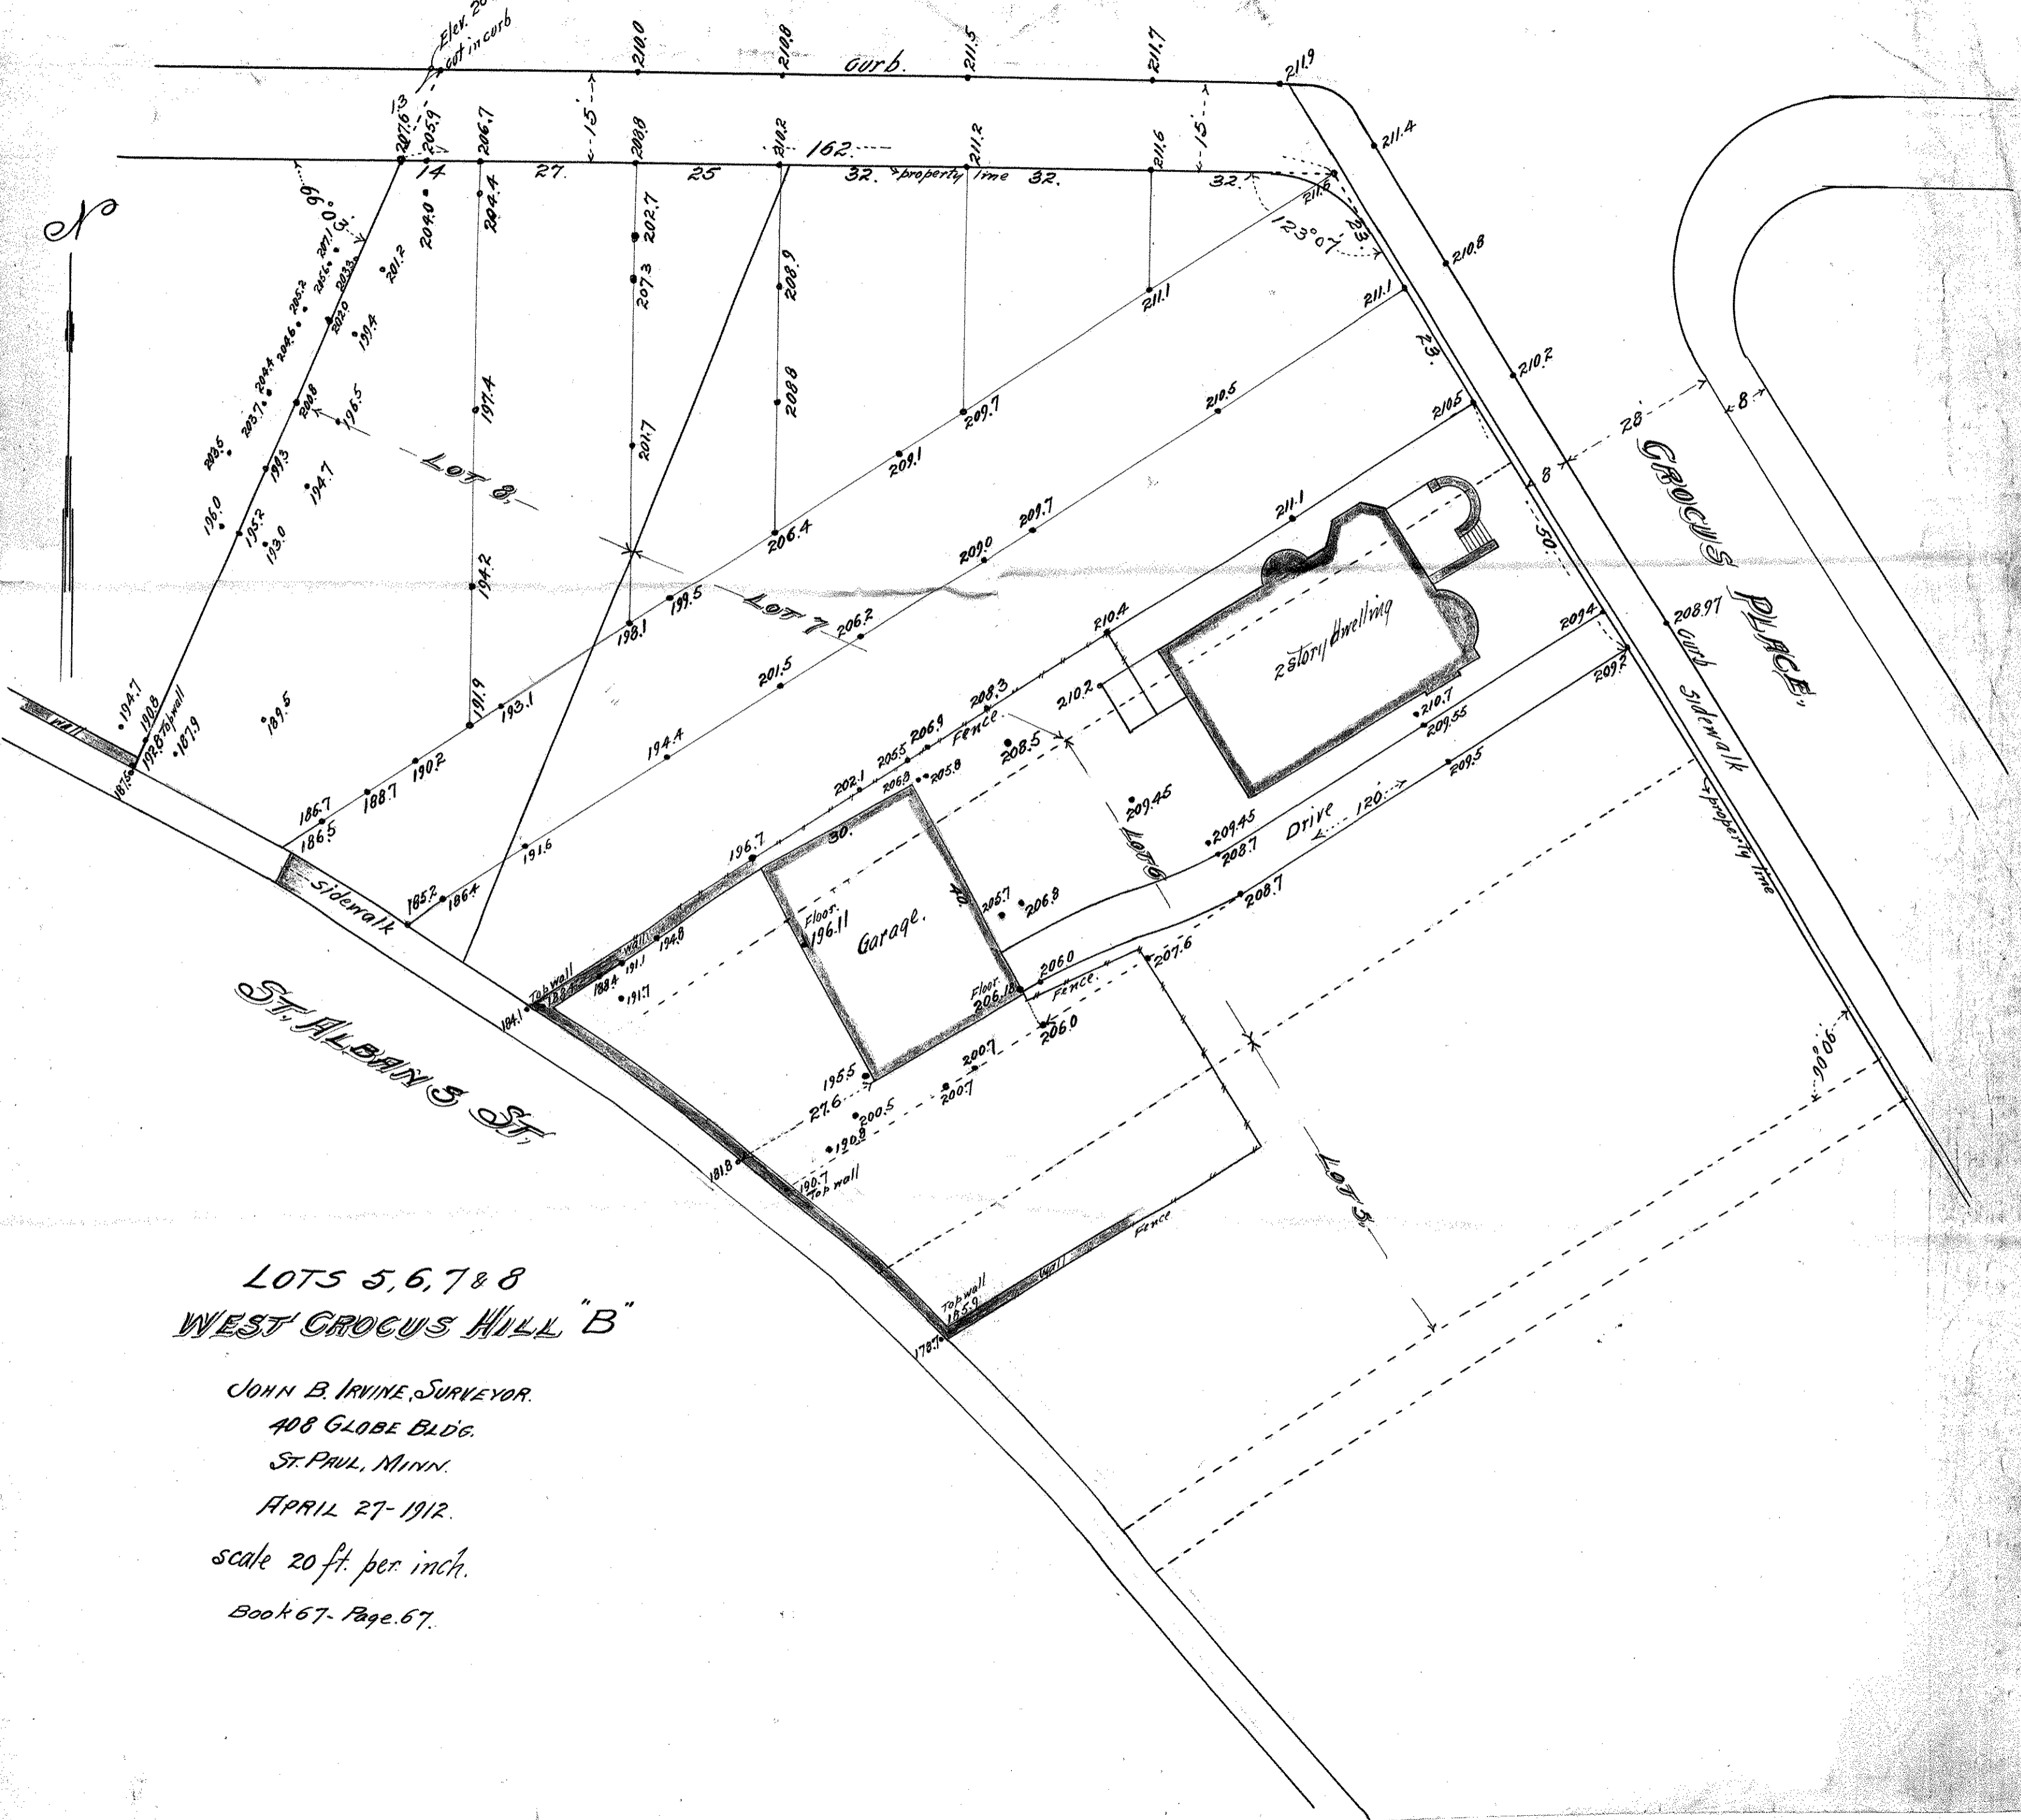

**LOTS 5, 6, 7 & 8  
 WEST CROCUS HILL "B"**

JOHN B. IRVINE, SURVEYOR.  
 408 GLOBE BLDG.  
 ST. PAUL, MINN.  
 APRIL 27-1912.

scale 20 ft. per inch.  
 Book 67- Page 67.