


CHAMBERS ST.

North line block 3

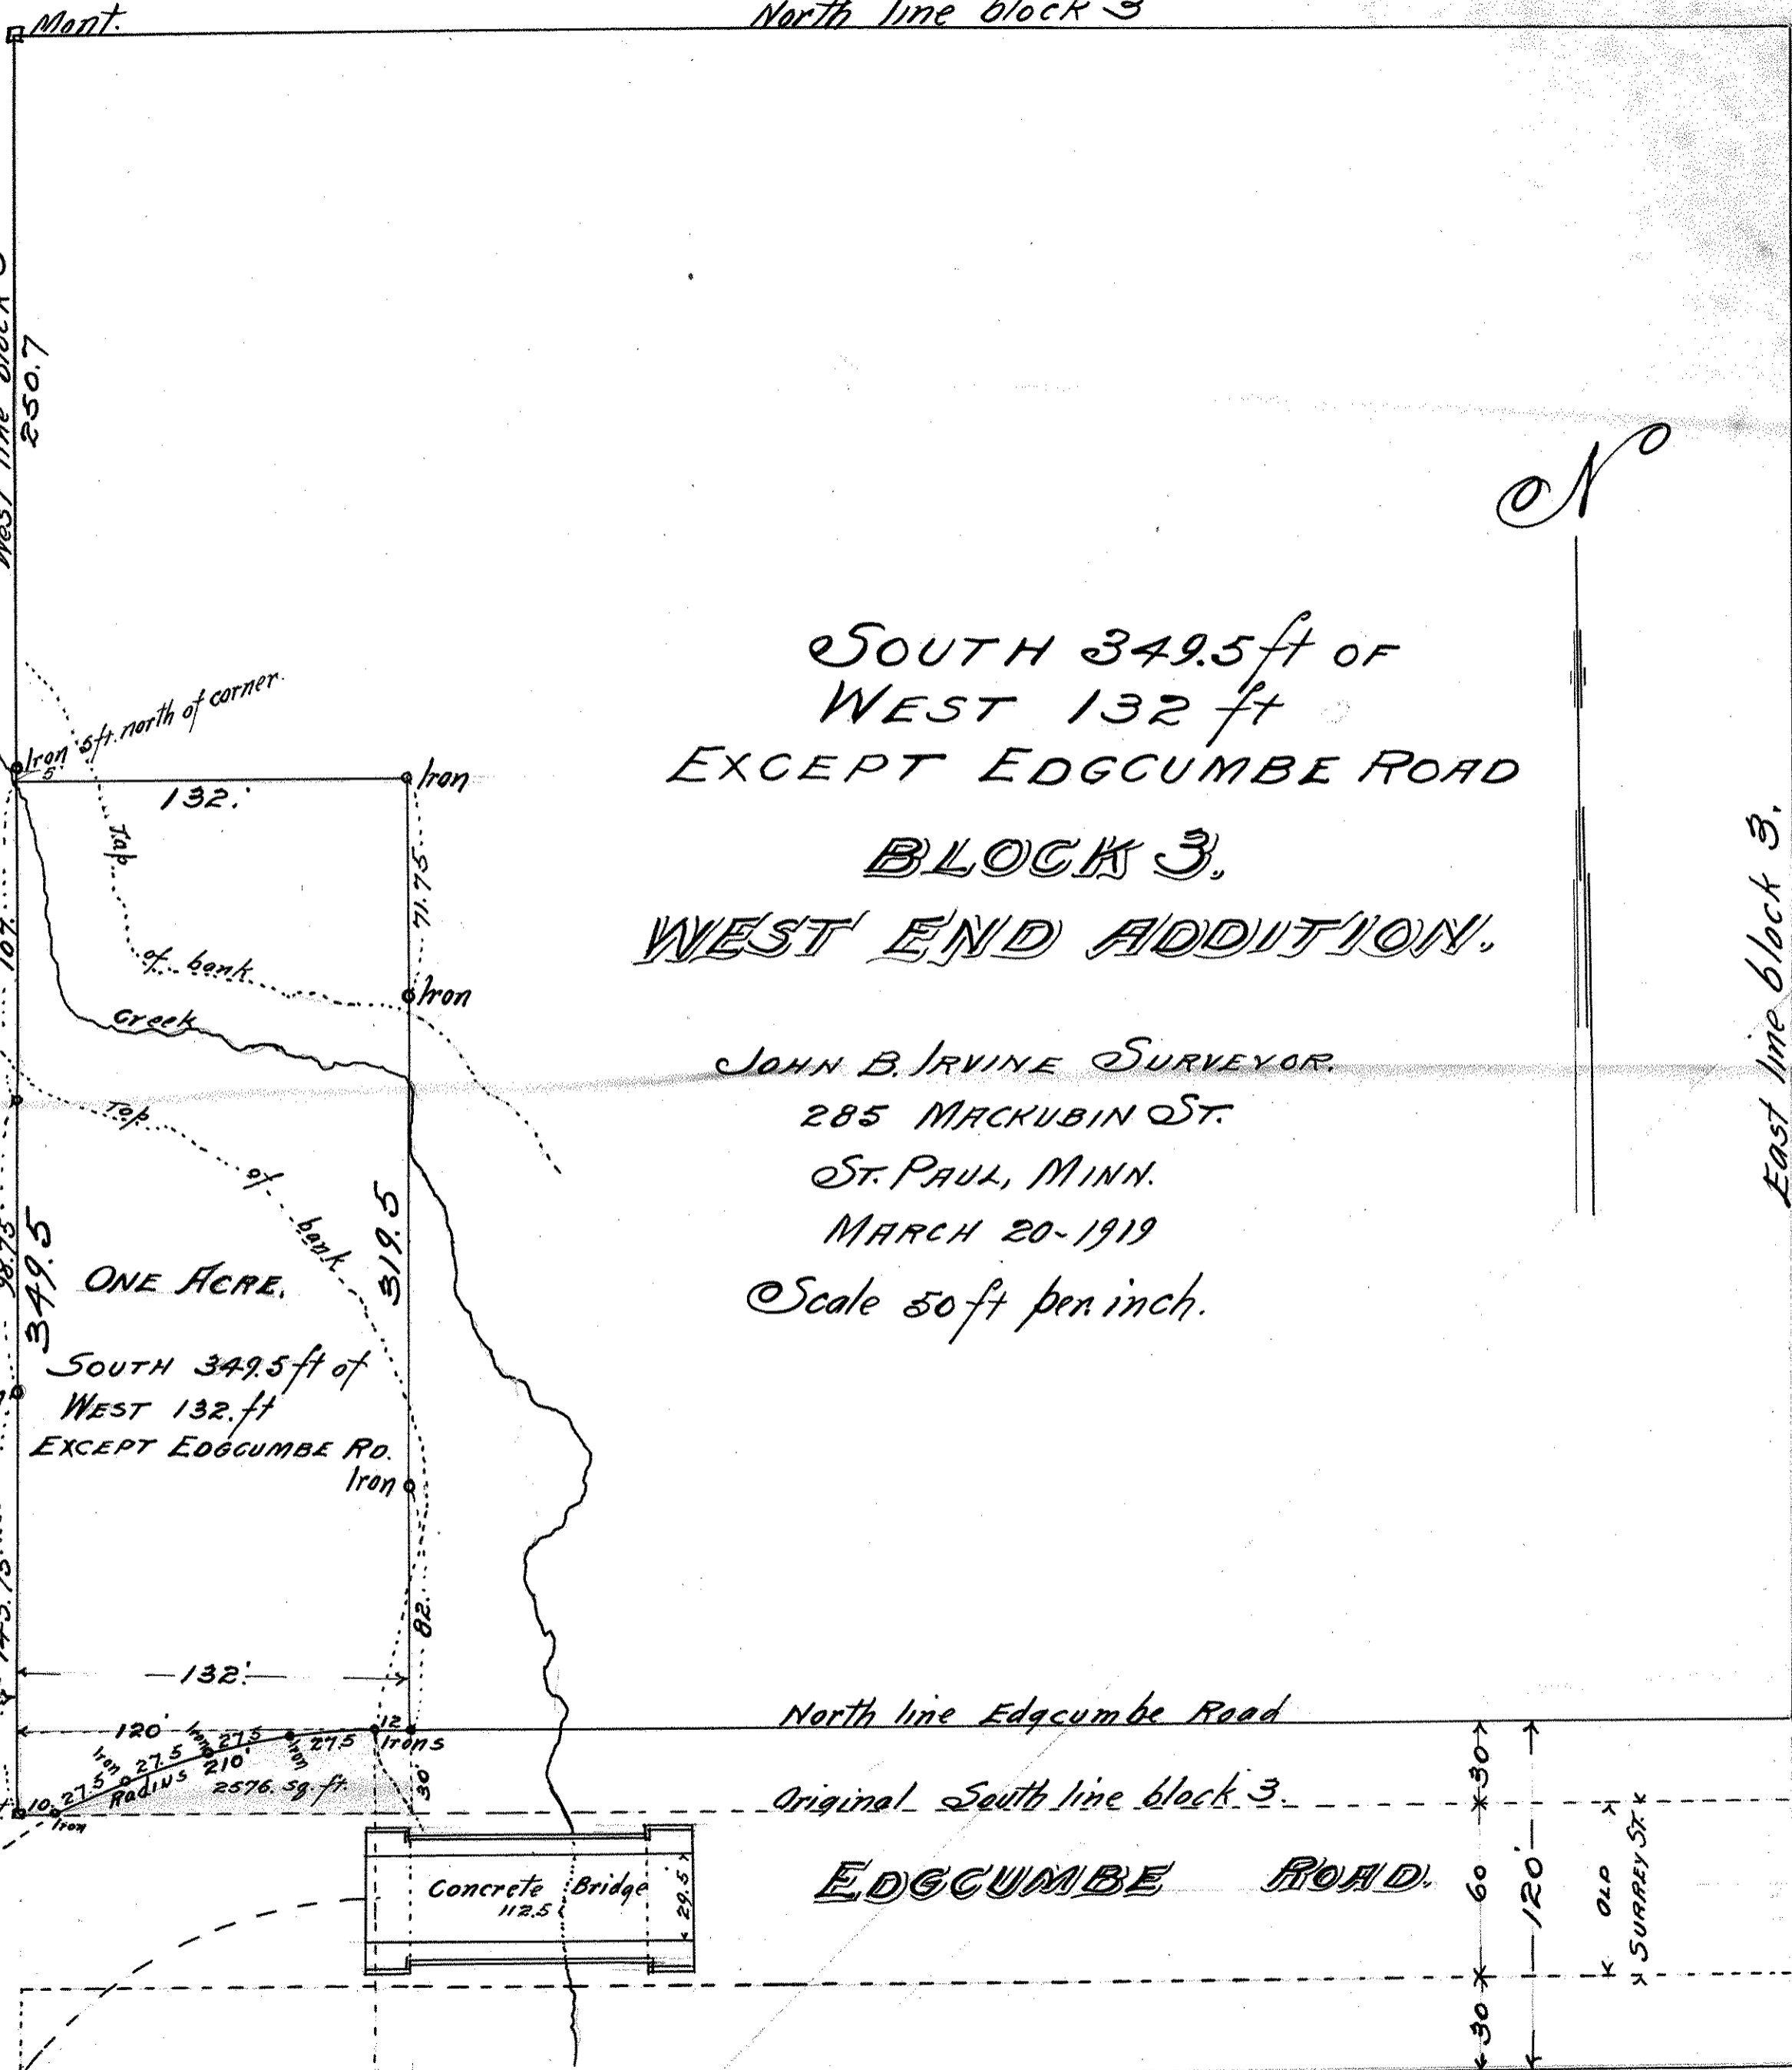

SOUTH 349.5 ft OF
 WEST 132 ft
 EXCEPT EDGCUMBE ROAD
 BLOCK 3,
 WEST END ADDITION.

JOHN B. IRVINE SURVEYOR,
 285 MACKUBIN ST.
 ST. PAUL, MINN.
 MARCH 20-1919
 ©Scale 50 ft per inch.



HUMBOLDT AVE.

East line block 3.
 ELSWORTH AVE.


ONE ACRE.
 SOUTH 349.5 ft of
 WEST 132 ft
 EXCEPT EDGCUMBE RD.

North line Edgumbe Road
 Original South line block 3.

EDGCUMBE ROAD.

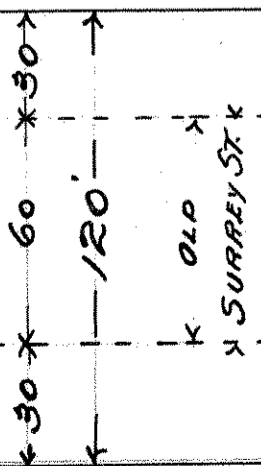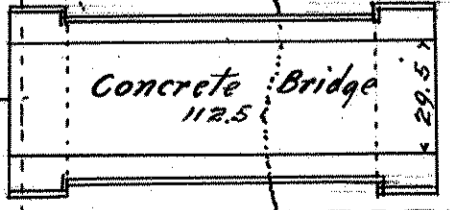


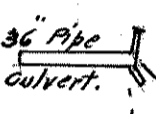

West line block 3
 250.7

Mont.

Iron

60'

Mont.

Iron

radius 210'

120' 27.5' 27.5' 210' Radius 2576.59 ft

349.5

Iron

Iron

143.75

132'

120'

10.275

Iron

107'

Iron

36" Pipe
 Culvert.

5 ft. north of corner.

132'

Tap

of bank.

Creek

Iron

Tap

of bank.










































Iron

71.75

Iron




