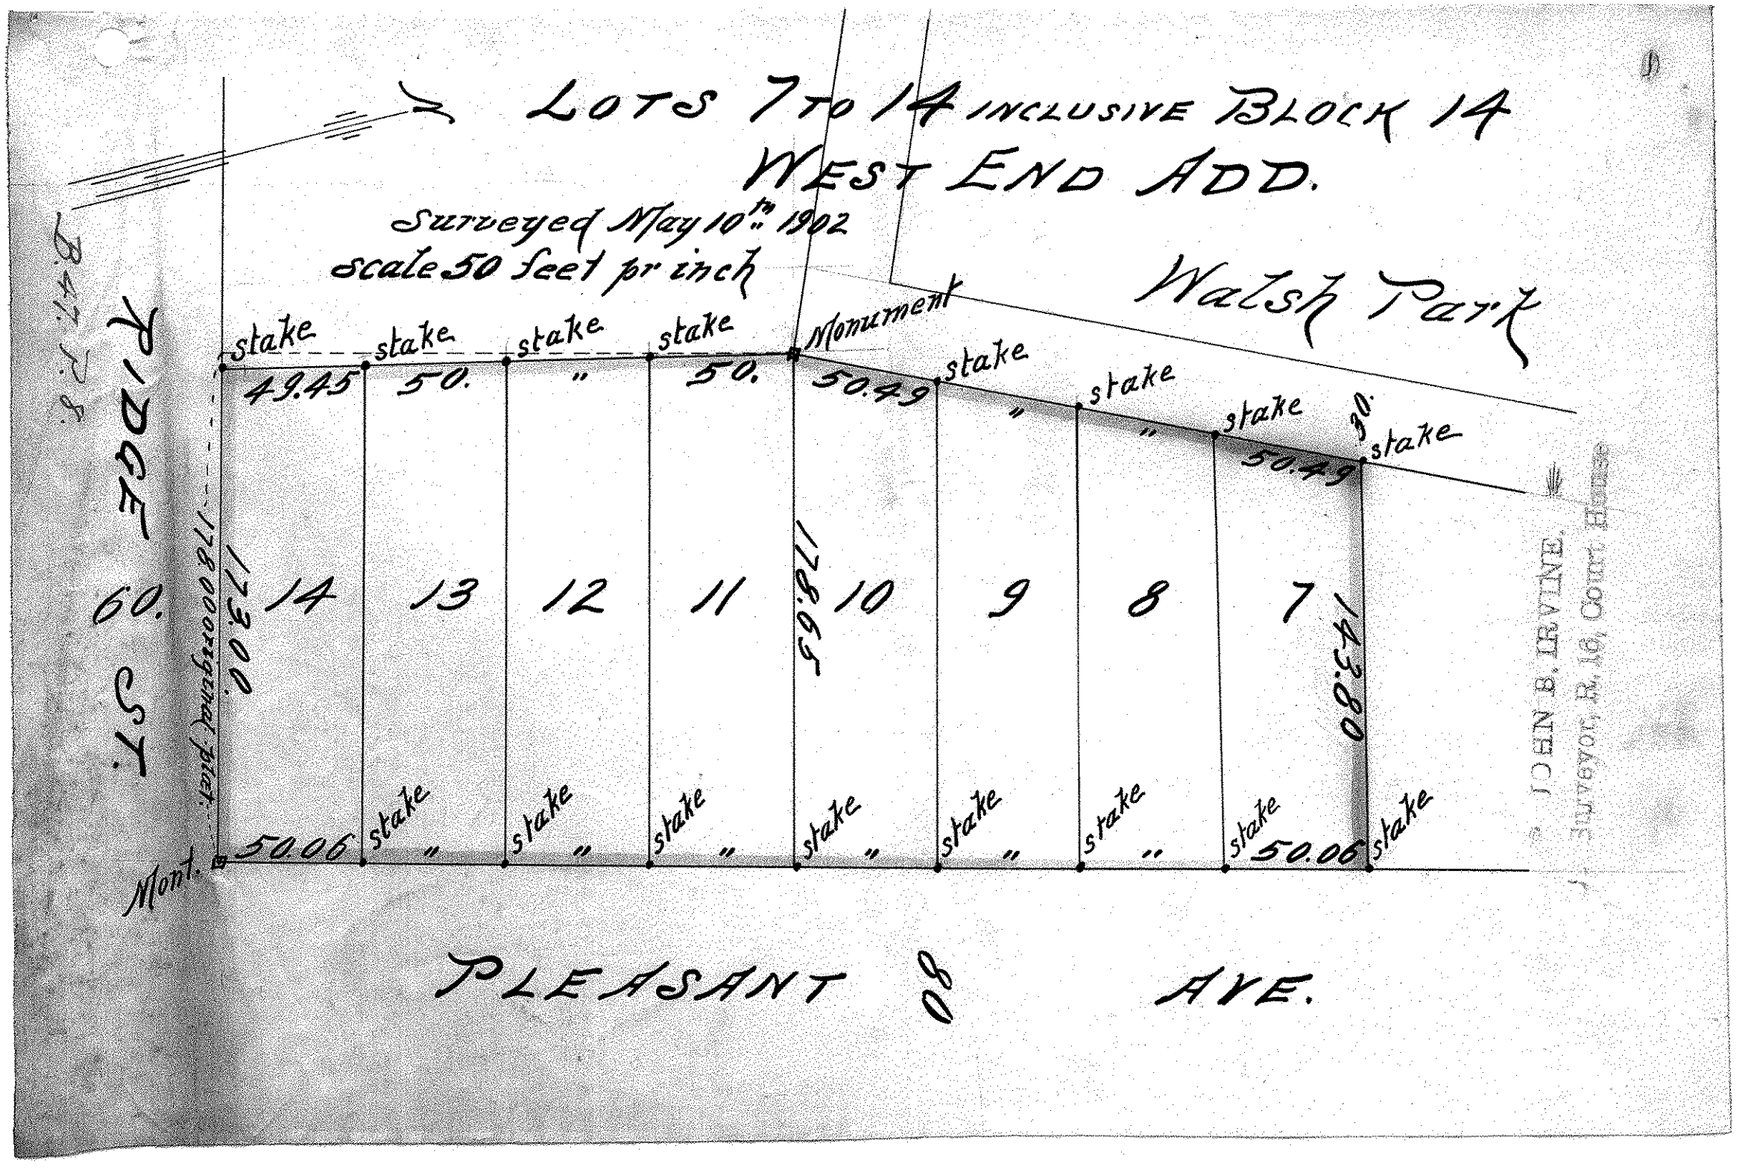
LOTS 7 TO 14 INCLUSIVE BLOCK 14
WEST END ADD.
Surveyed May 10th 1902
scale 50 feet pr inch
Walsh Park
stake
49.45
stake
50.
stake
"
stake
50.
Monument
50.49
stake
"
stake
"
stake
50.49
30.
stake
60.
173.00
178.00 original plat.
14
13
12
11
178.65
10
9
8
7
143.80
Mont.
50.06
stake
"
stake
"
stake
"
stake
"
stake
"
stake
"
stake
50.06
stake
PLEASANT AVE.
80
RIDGE ST.
B.47. P.8.
JOHN B. IRVINE,
Surveyor, R. 16, Court House