


LOTS 1 & 2 BLOCK 39
WEST END ADD.

WEST SEVENTH ST.

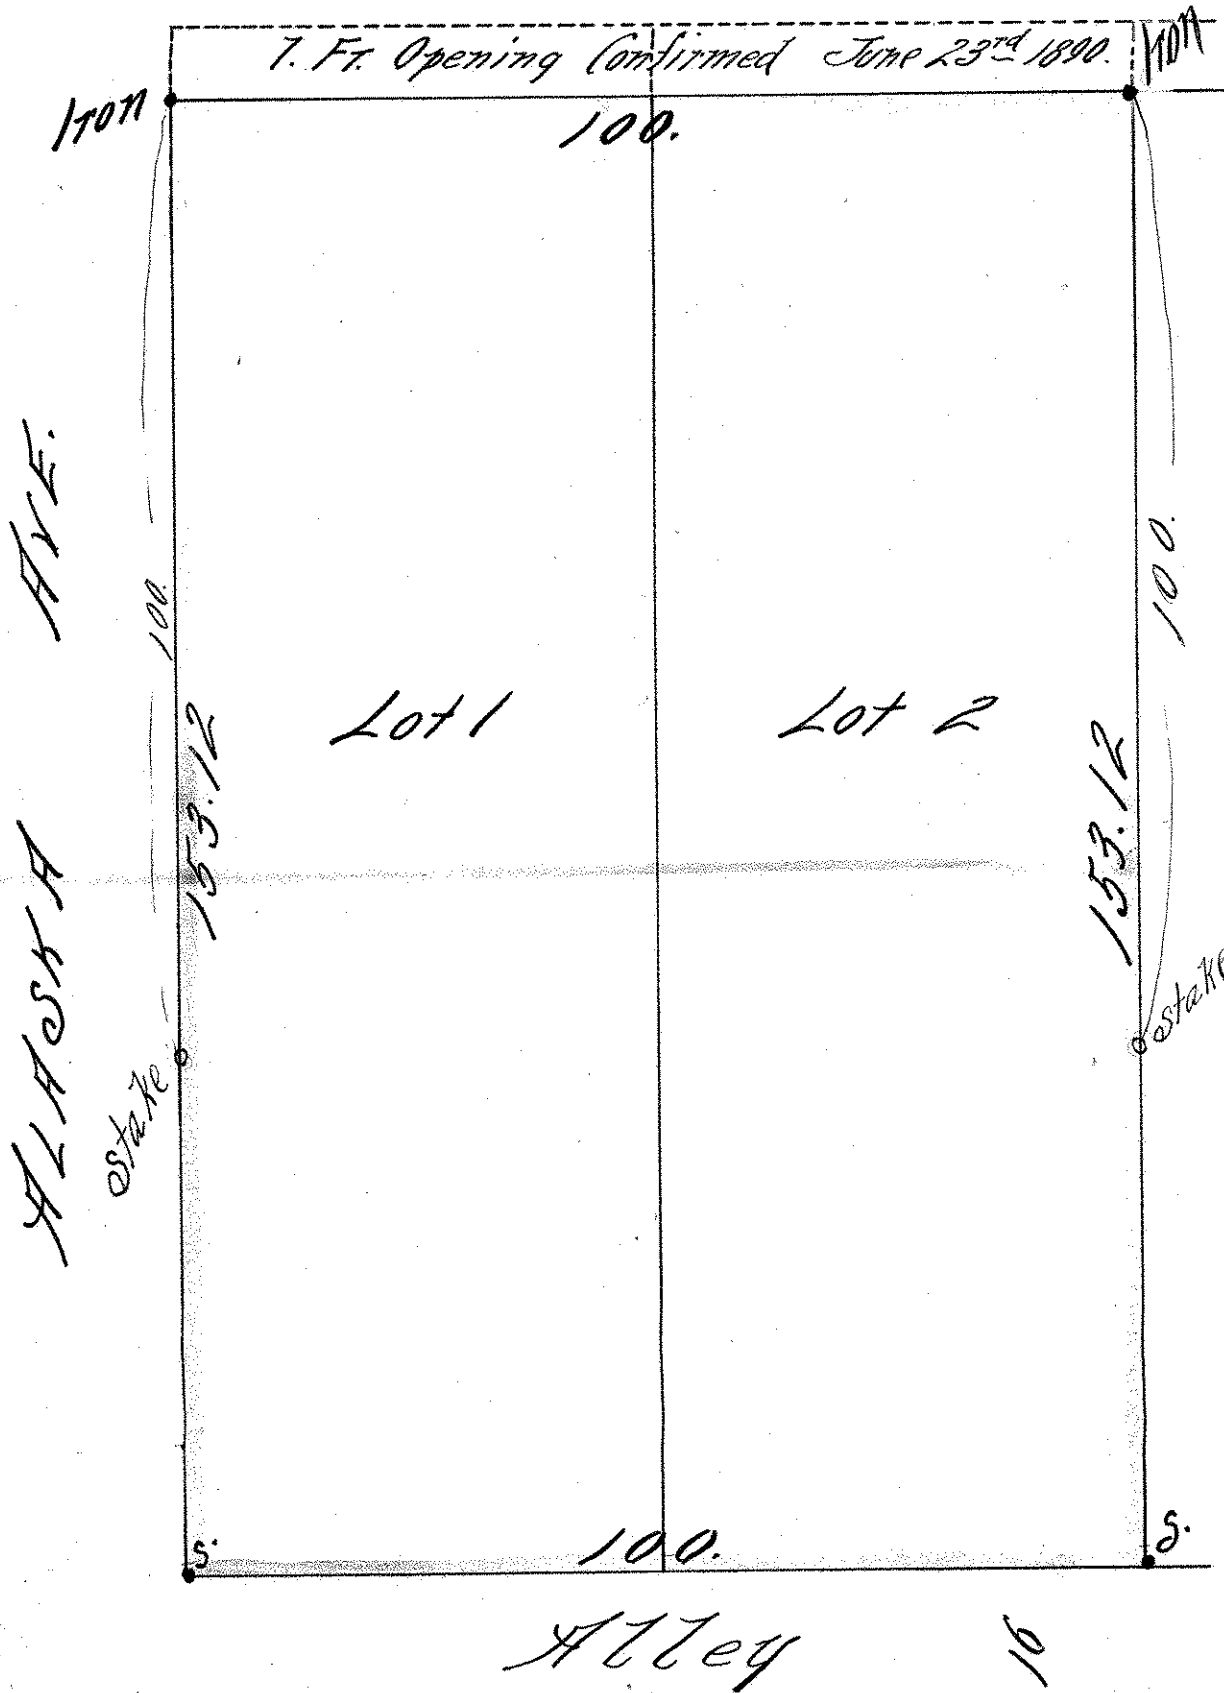

Scale 20' = 1"

Albert Masek
Sept. 25th 1903.