

LOTS 8-9 BLK. 29.


West End. Add.

John B. Irvine Sur.

Scale 20' = 1"

McK. 10-05

16'
Alley.

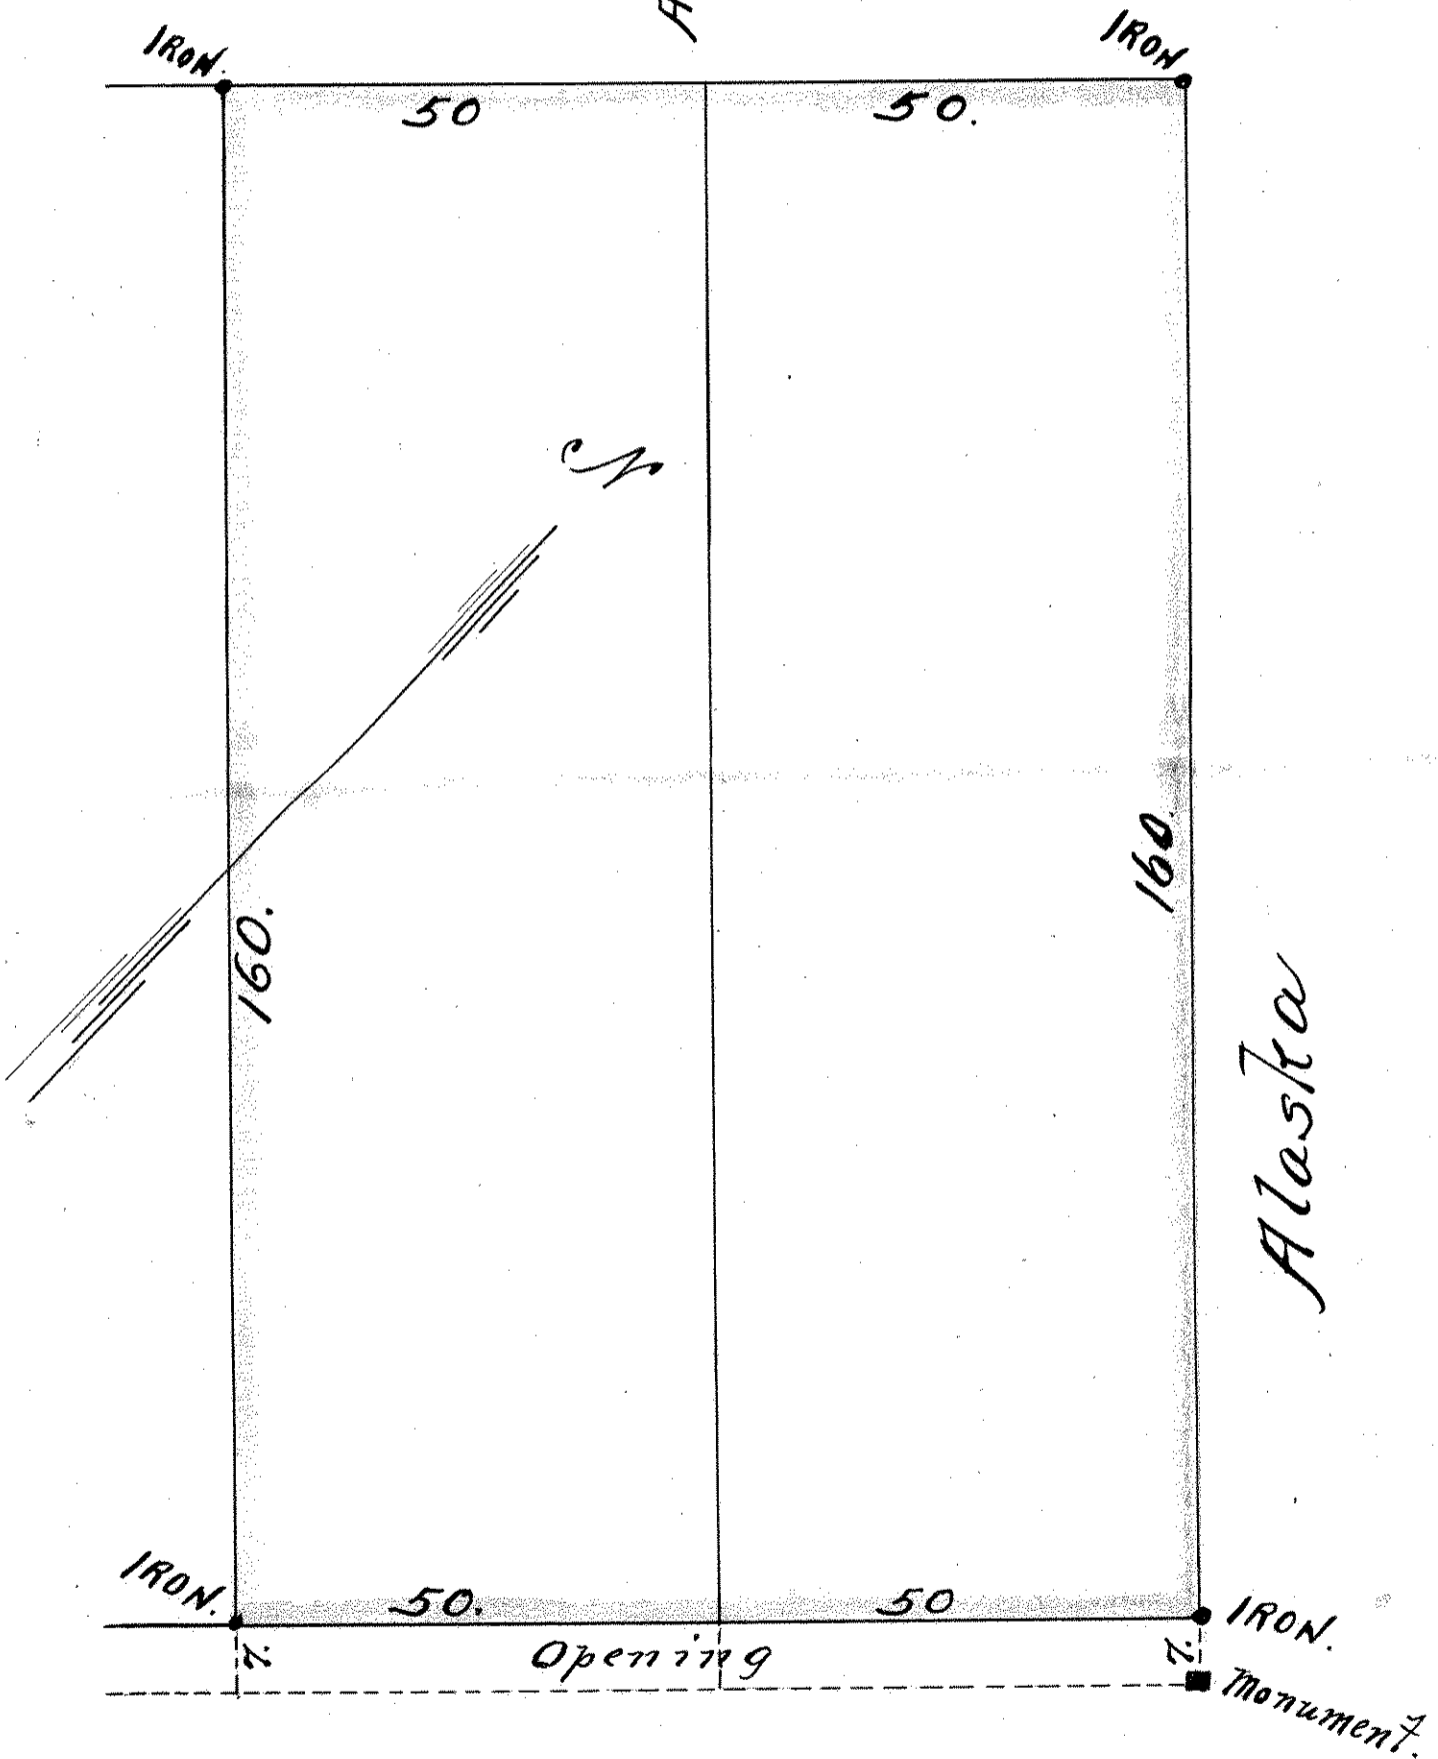

W. Seventh St.