


LOT 1 BLOCK 34
WEST END ADD.

Iron RACE ST.

Iron

50.

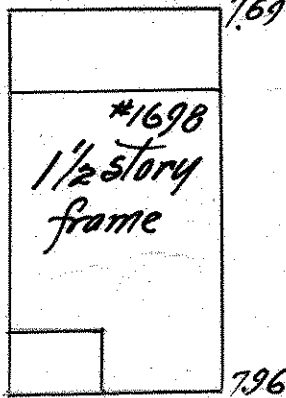

ALASKA AVE.

167.

167.

LOT 1.

50.

Iron ALLEY

Iron bolt.

John B. Irvine Surveyor
May 29-1919. Scale 20 ft. per inch.