


LOT 3 BLOCK 34  
WEST END ADD.  
N. ELY. 50 ft. LOT 6 BIK. 11  
BIRMINGHAM'S 4th ADD.

JOHN B. IRVINE, SURVEYOR.  
ST. PAUL, MINN.

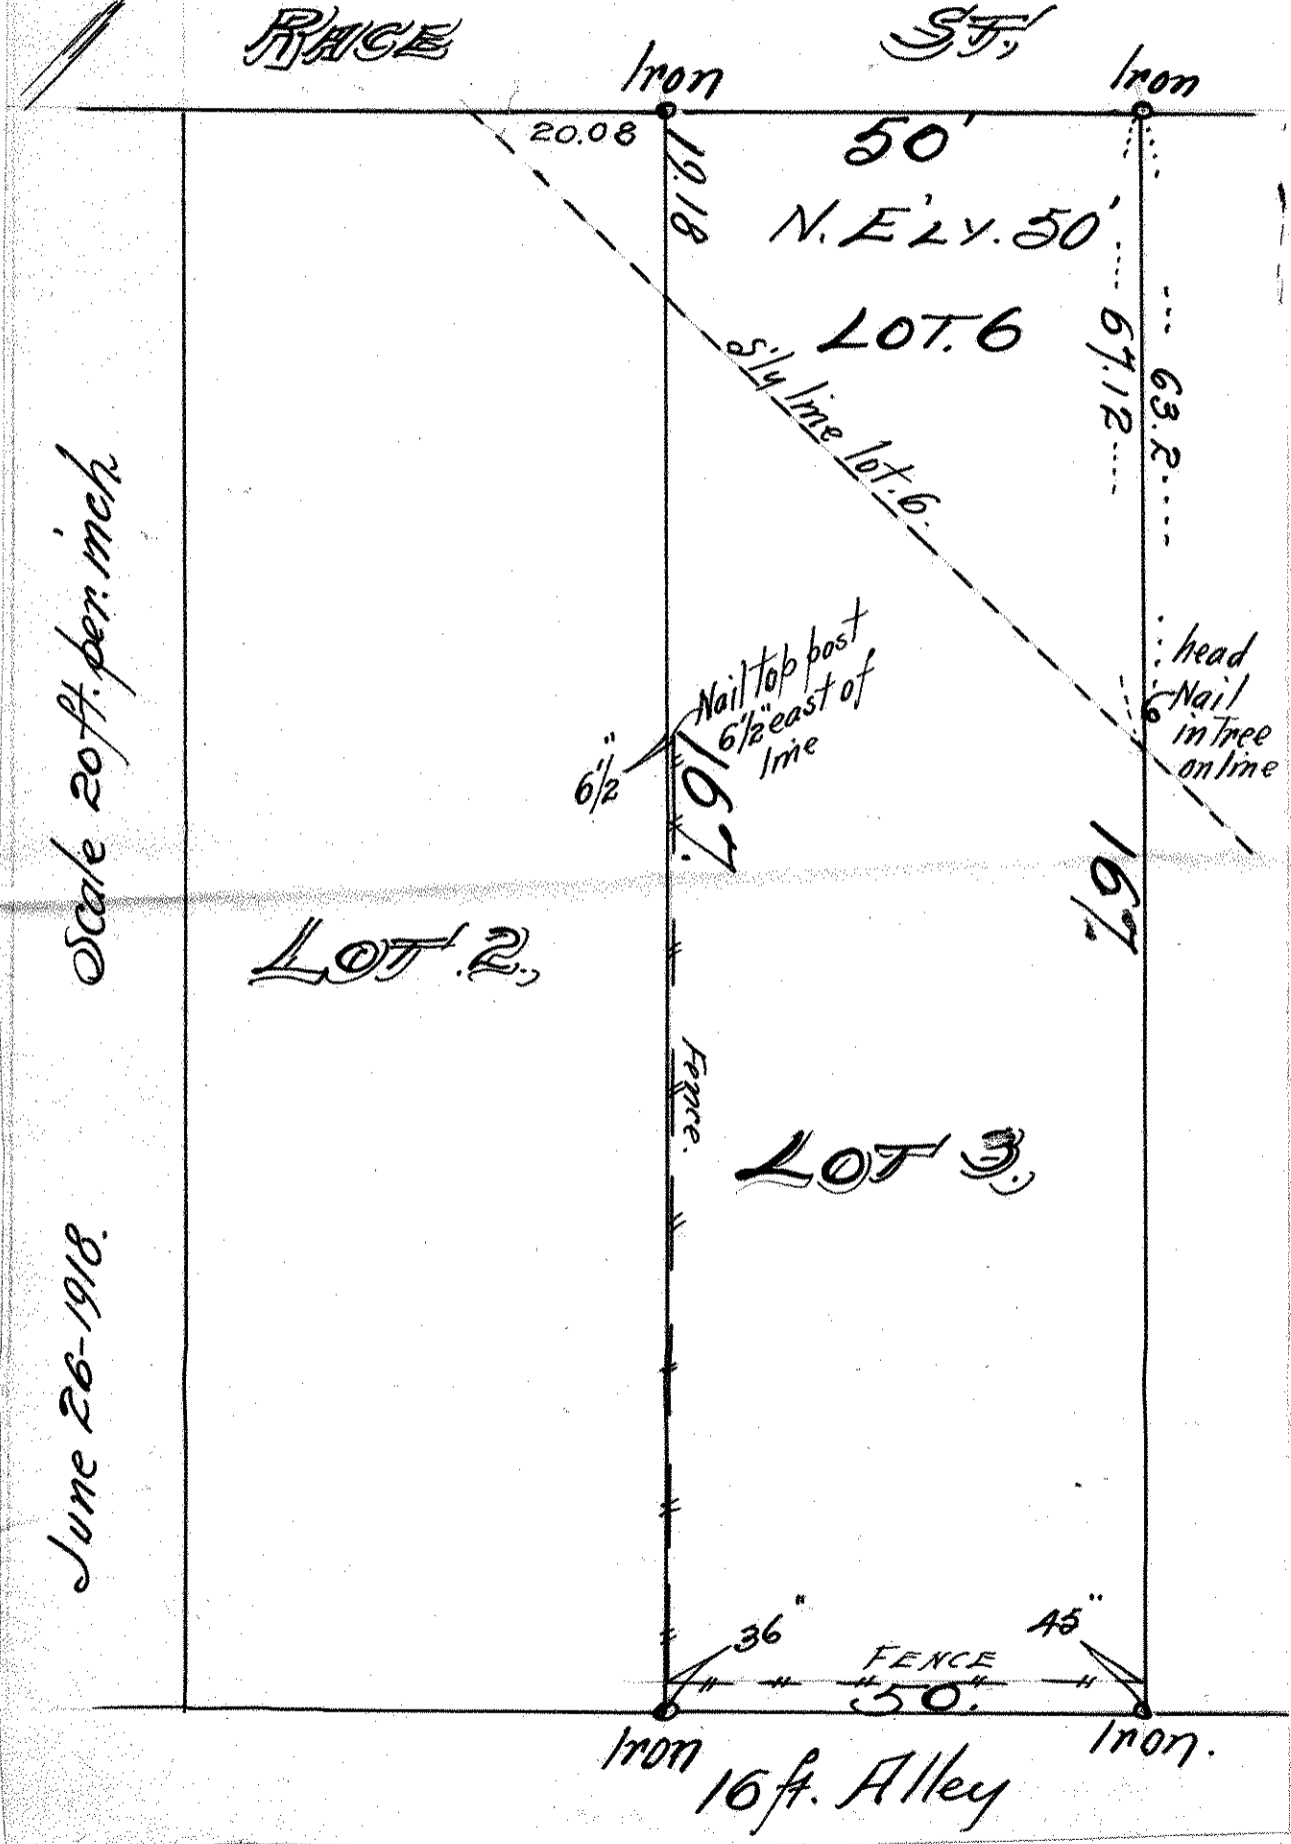

Scale 20 ft. per inch

June 26-1918.