


LOTS 3 AND 4 BLOCK 39  
WEST END ADDITION  
20 ft. pr. in.

SUN. Oct. 6<sup>th</sup> 1902

West End Addition

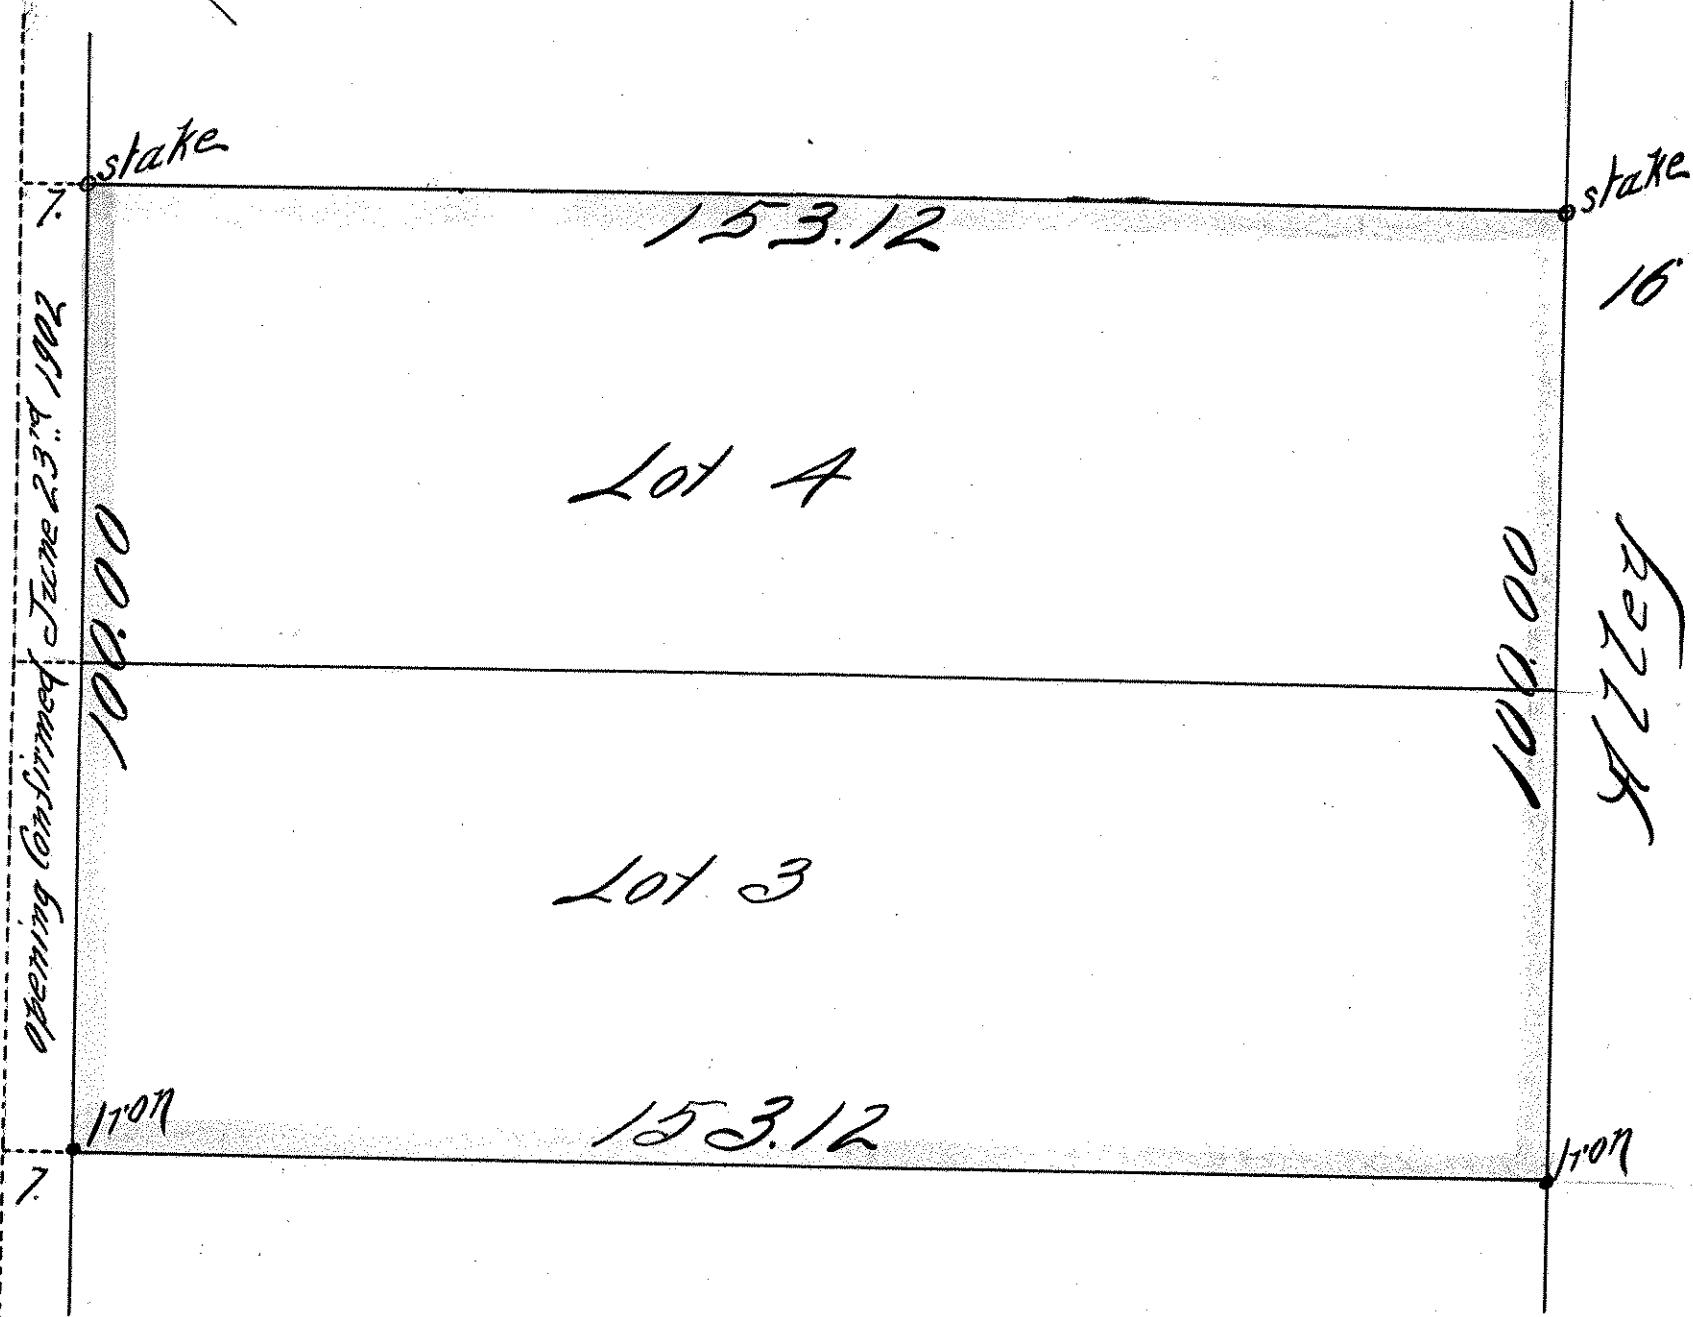

B. 53. P. 4