
BLOCK 20

W. ST PAUL PROPER

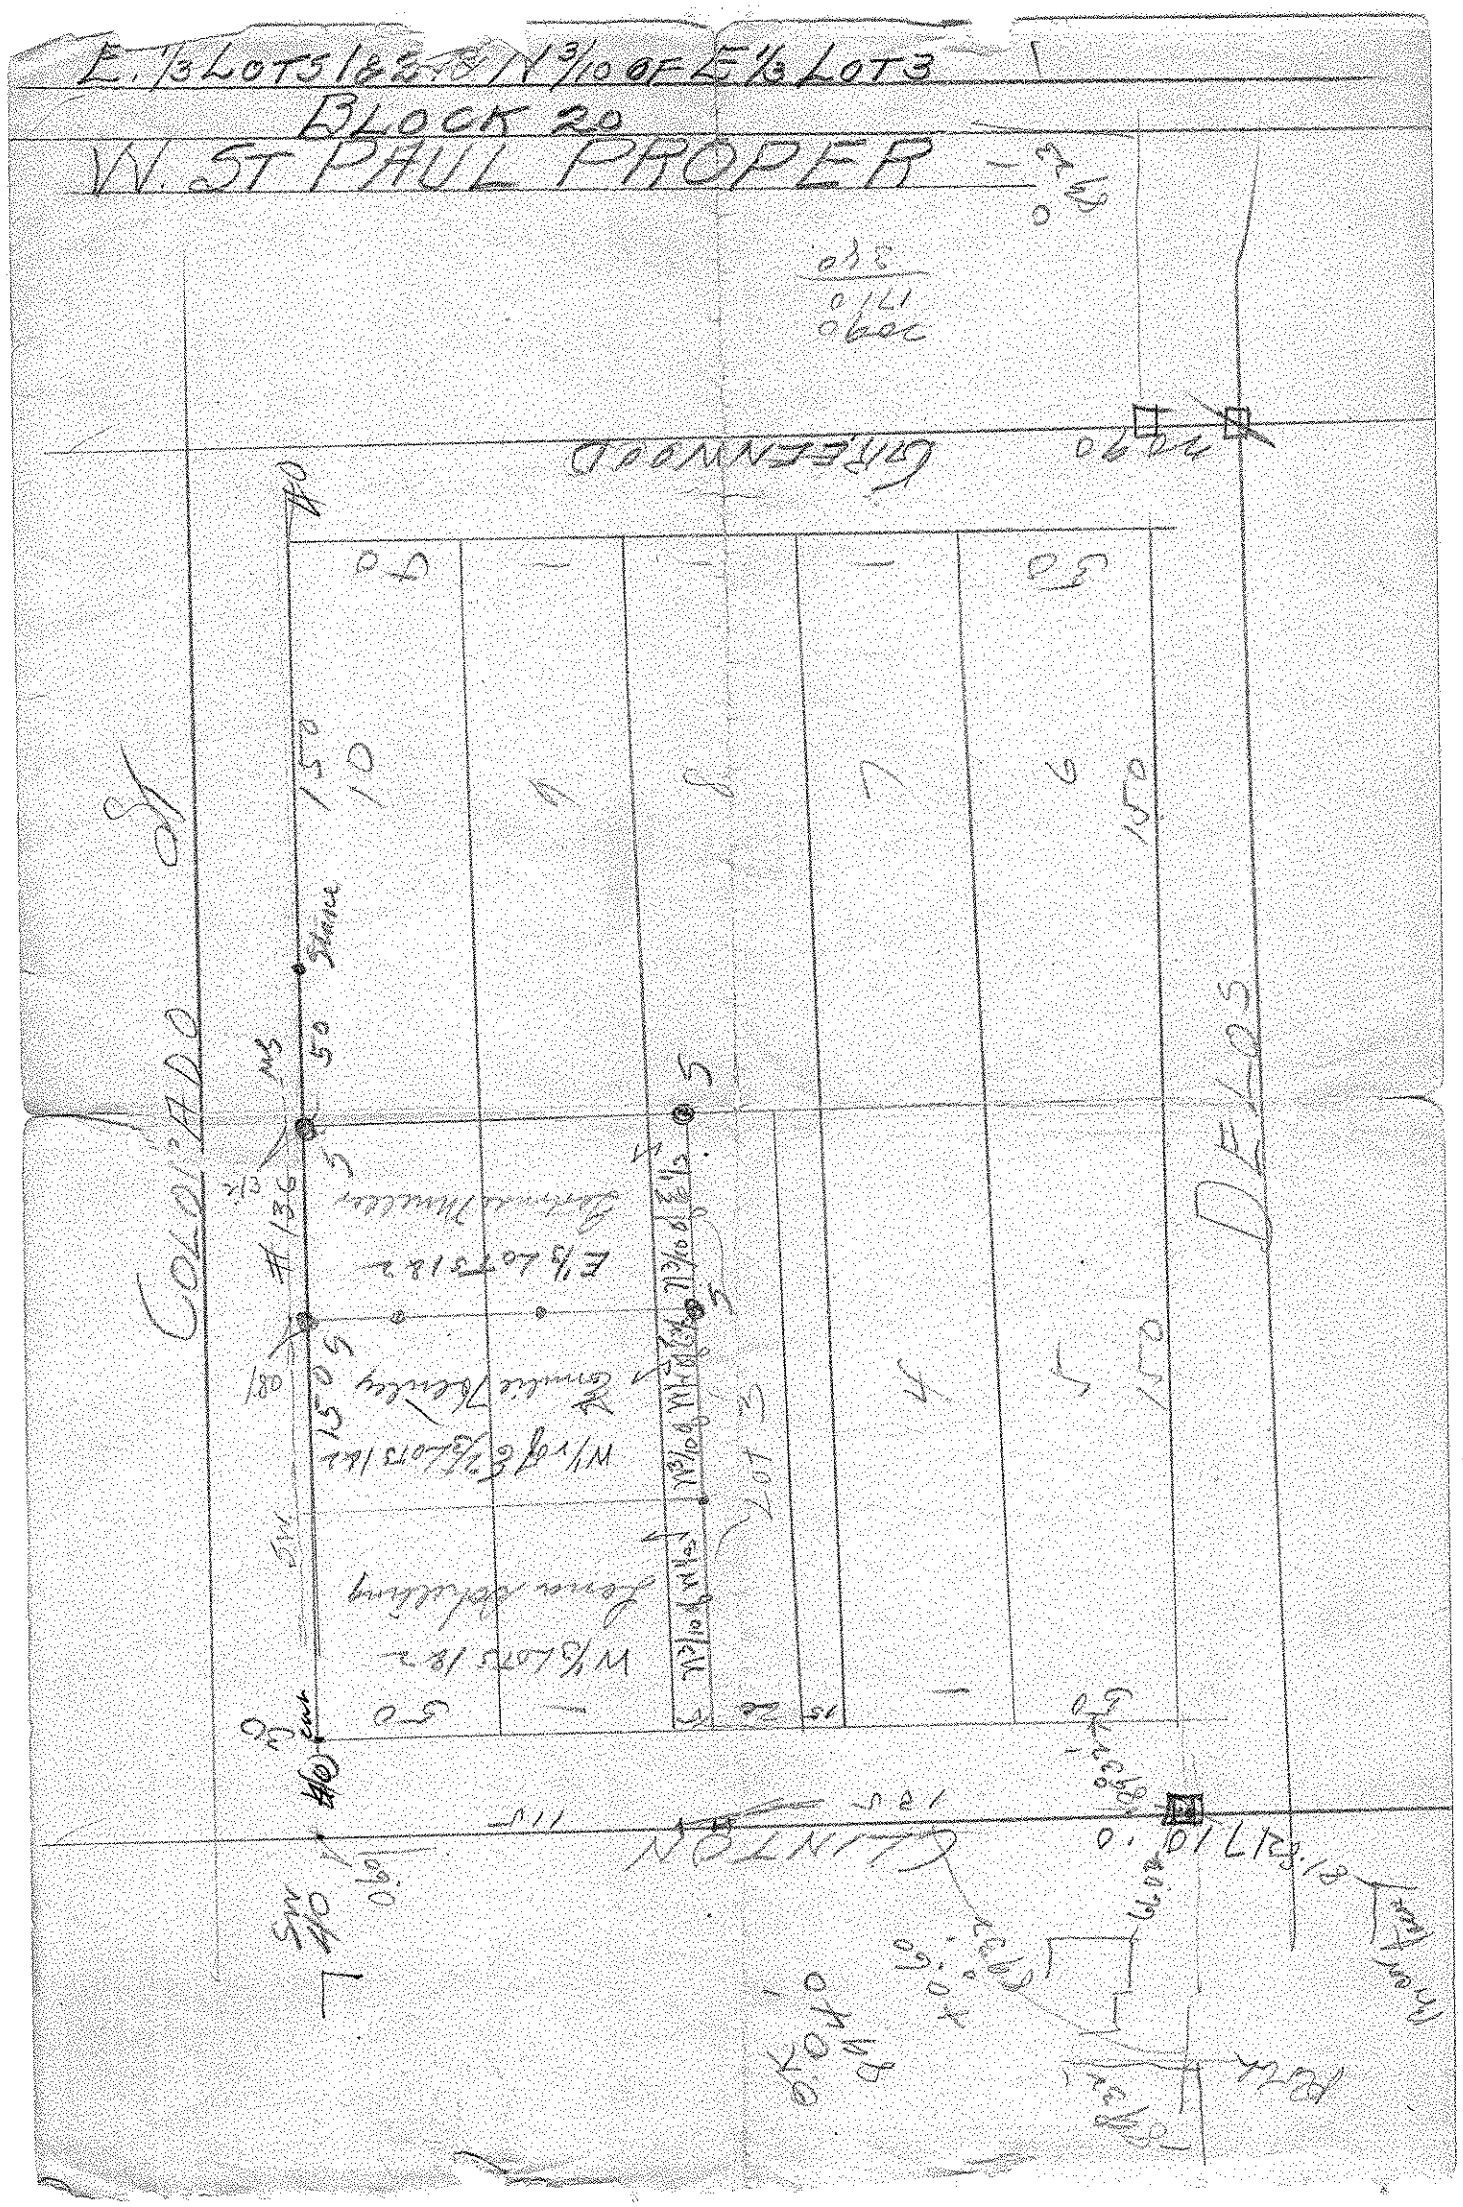
COLORADO
Stone
Stone
Stone