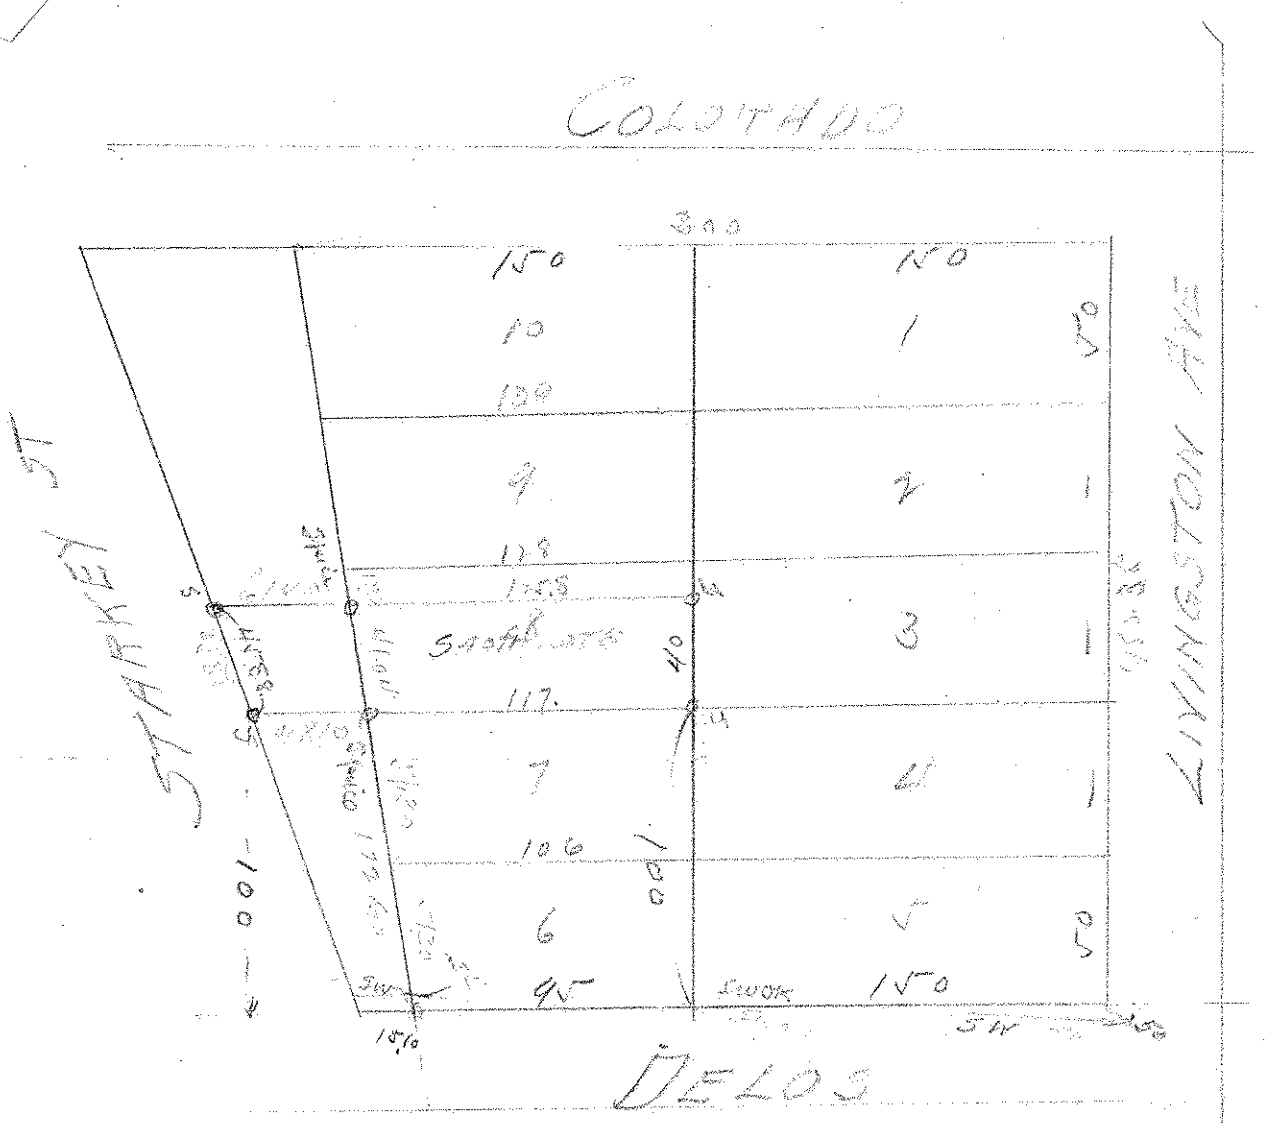
COLORADO
DELOS
LIVINGSTON AVE
STARKEY ST
150
10
129
9
118
8
117
7
106
6
95
1
2
3
4
5
150
150
150
150
100
100
40
40
100
100
SW
SW
SW