


WINSLOW AVE 80

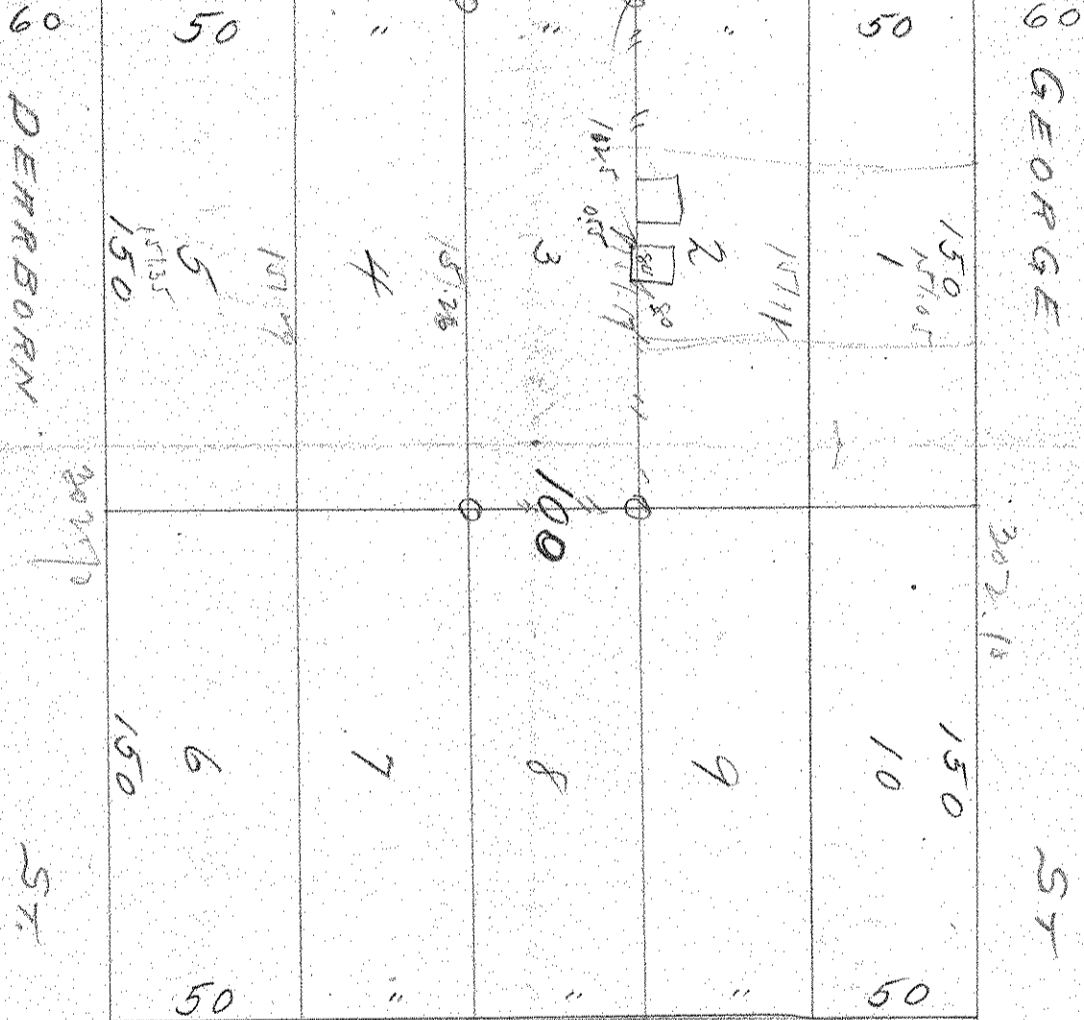

STRYKER AVE 80