


ELIZABETH

SOBIBENT

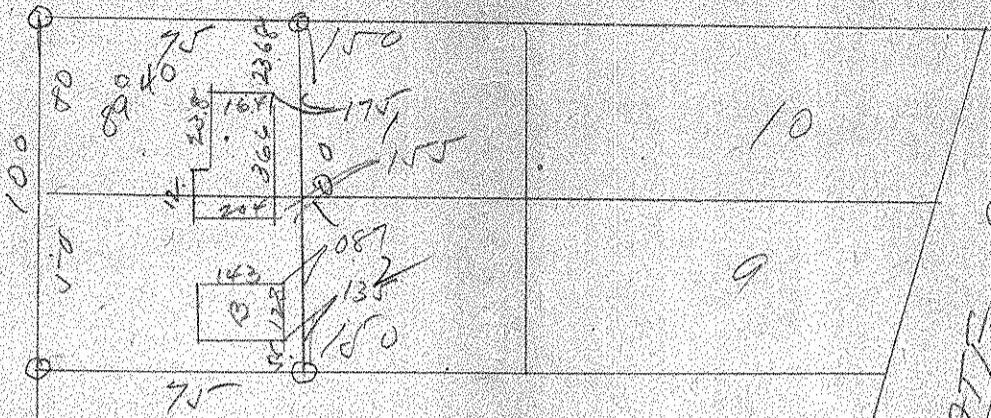

STATE ST