


Compras

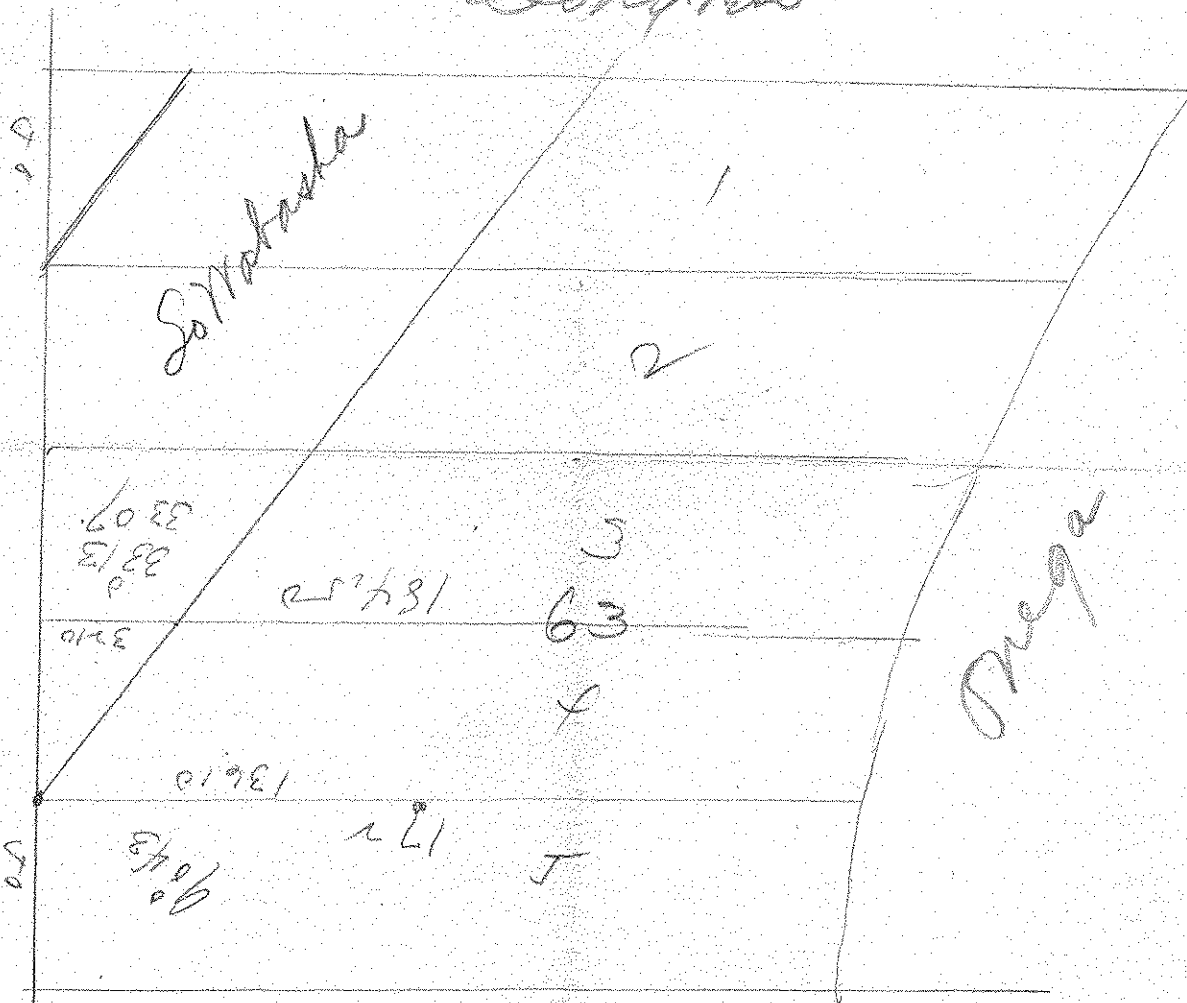

Winnifred