

Dearborn



33640

5 Robert St

Maurice St

Louisa

State

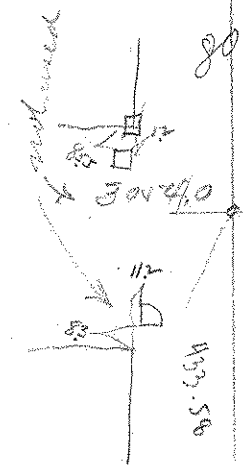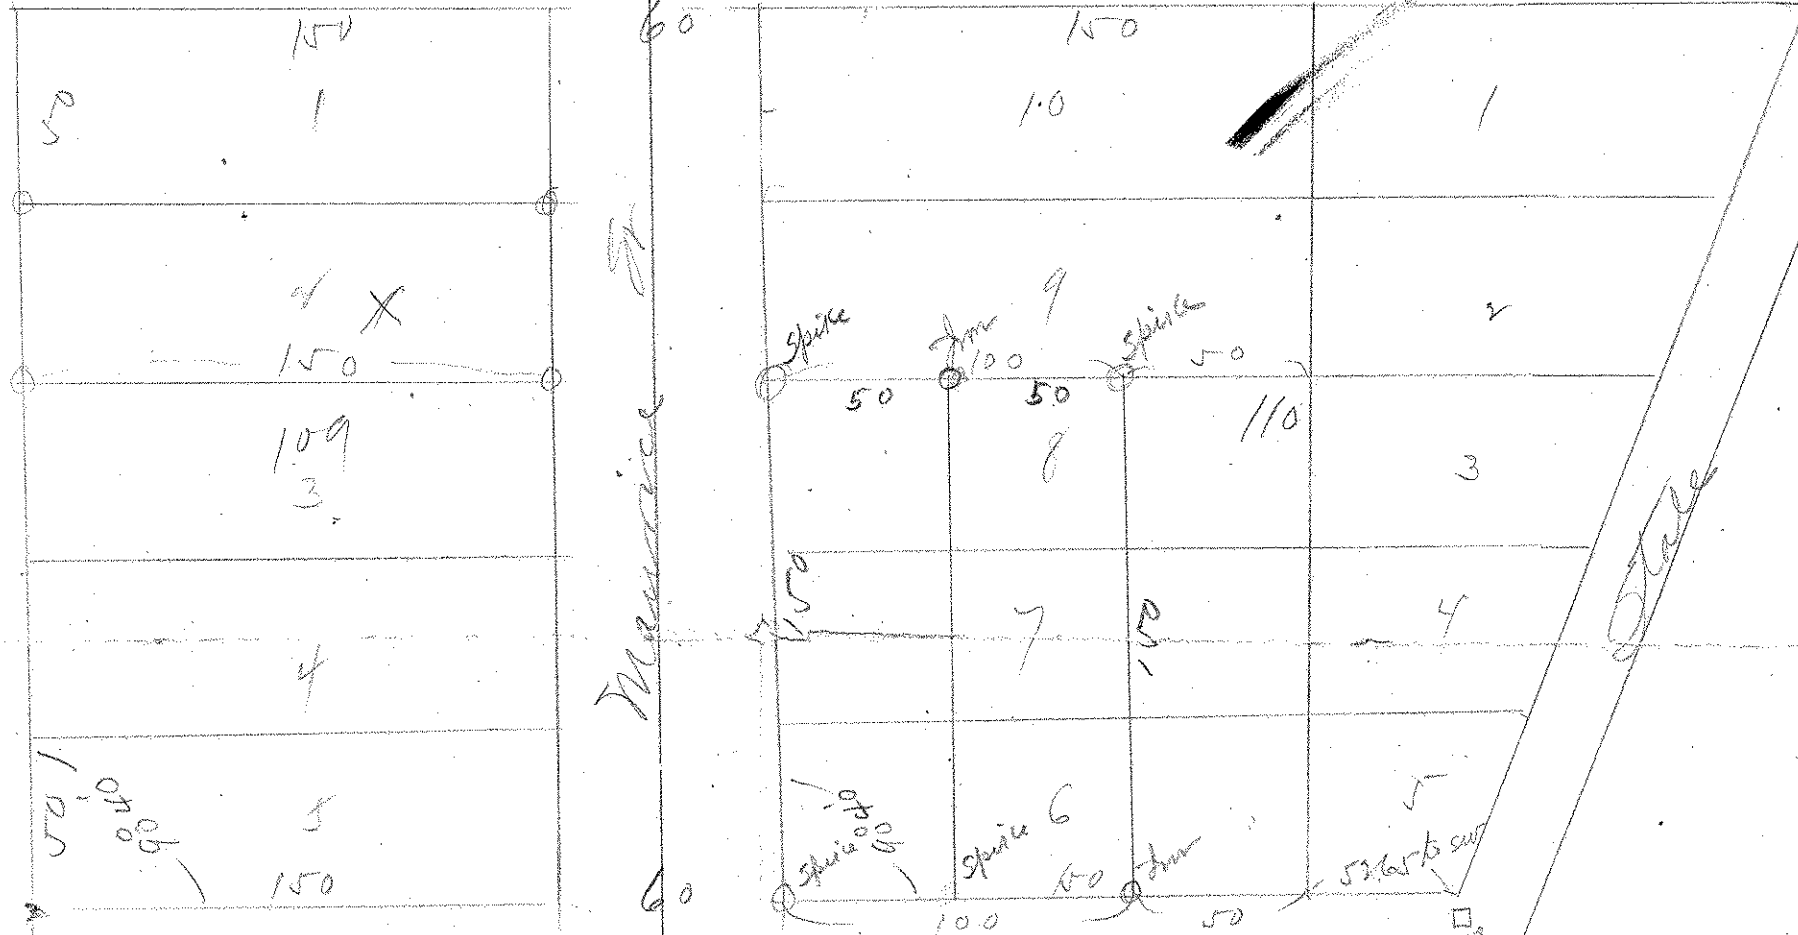

3054.0
 2020 42
 43308