


W 1/2 OF LOTS 9-10 AND THE E. 125 FT  
OF LOTS 1-2 also E 125 OF N 1/4 LOT 3 BLK 84

ROBIE 300 = E 3007 M ST 7-3-50

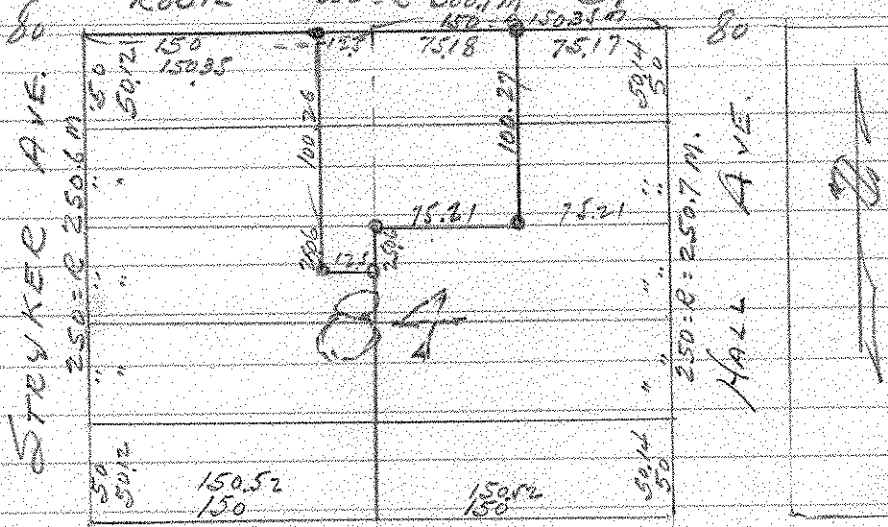

STRICKER AVE.  
250 = E 250.6 M

HALL AVE.  
250 = E 250.7 M.

300 = R = 303.04 M  
GEORGE ST

WEST ST. PAUL PROPER.