


LOT 3 BLOCK 21  
WEST ST. PAUL PROPER.

Scale 20. Feet pr. inch

W. ROBERT ST.

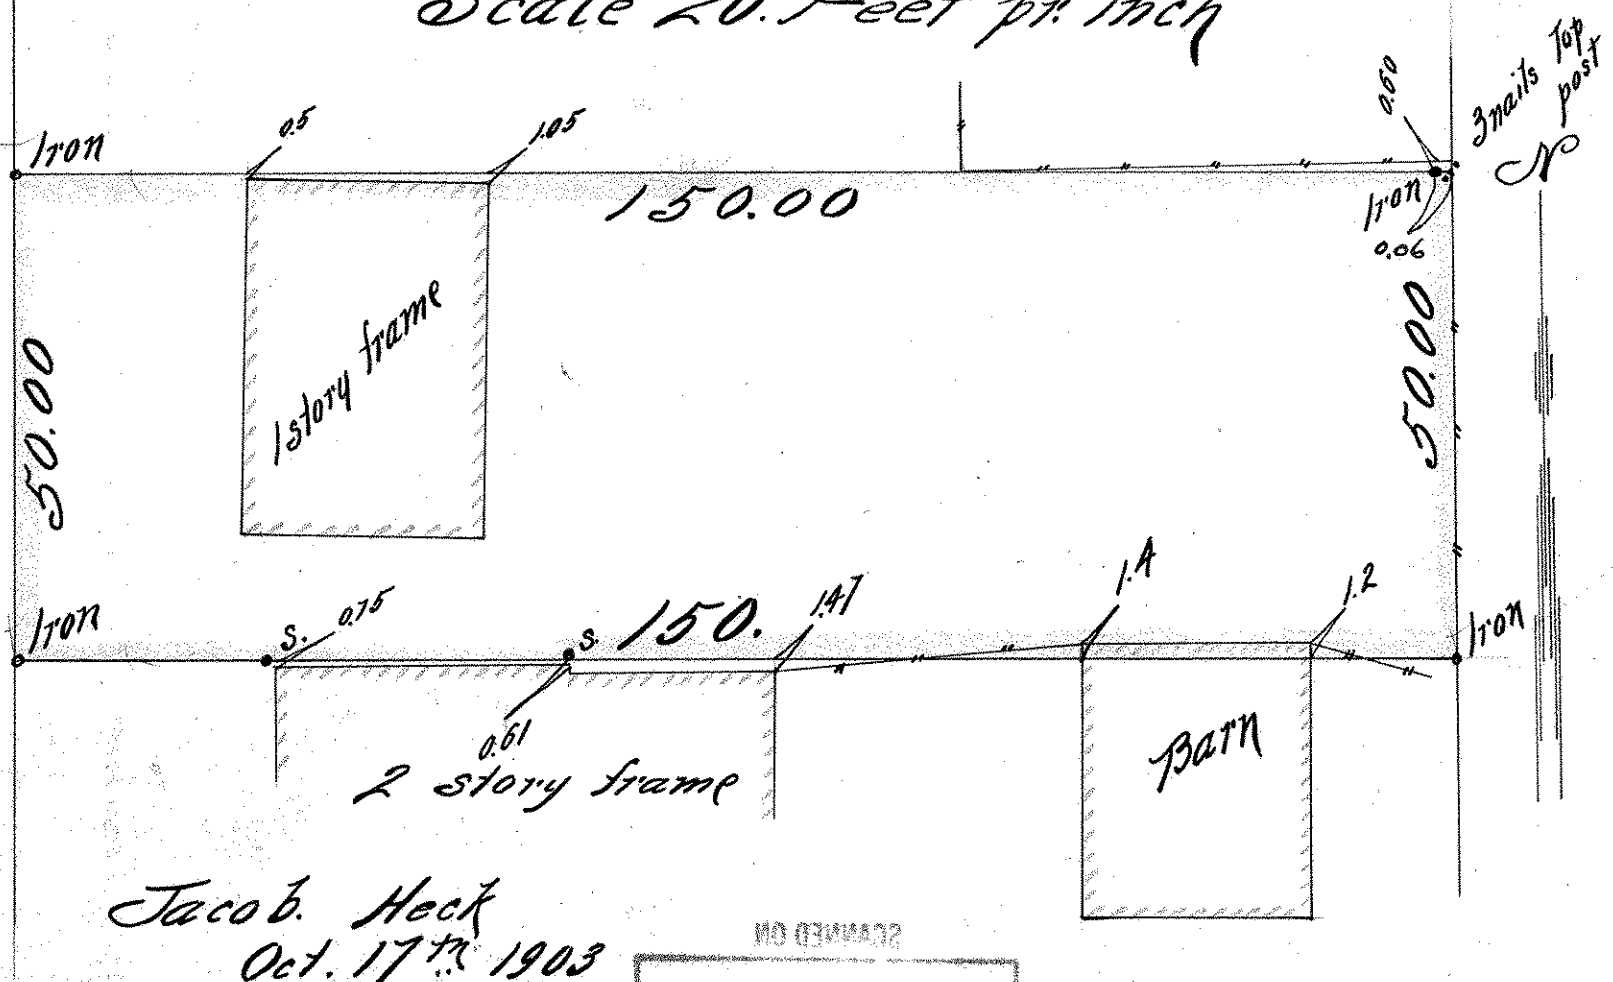

Jacob Heck  
Oct. 17<sup>th</sup> 1903

NO 031112

