

LOT 5 BLOCK 5

WEST ST. PAUL PROPER.


JOHN B. IRVINE, SURVEYOR.

408 GLOBE BLDG.


ST. PAUL, MINN.

AUG. 23-1911.

SCALE 100 ft. per inch.

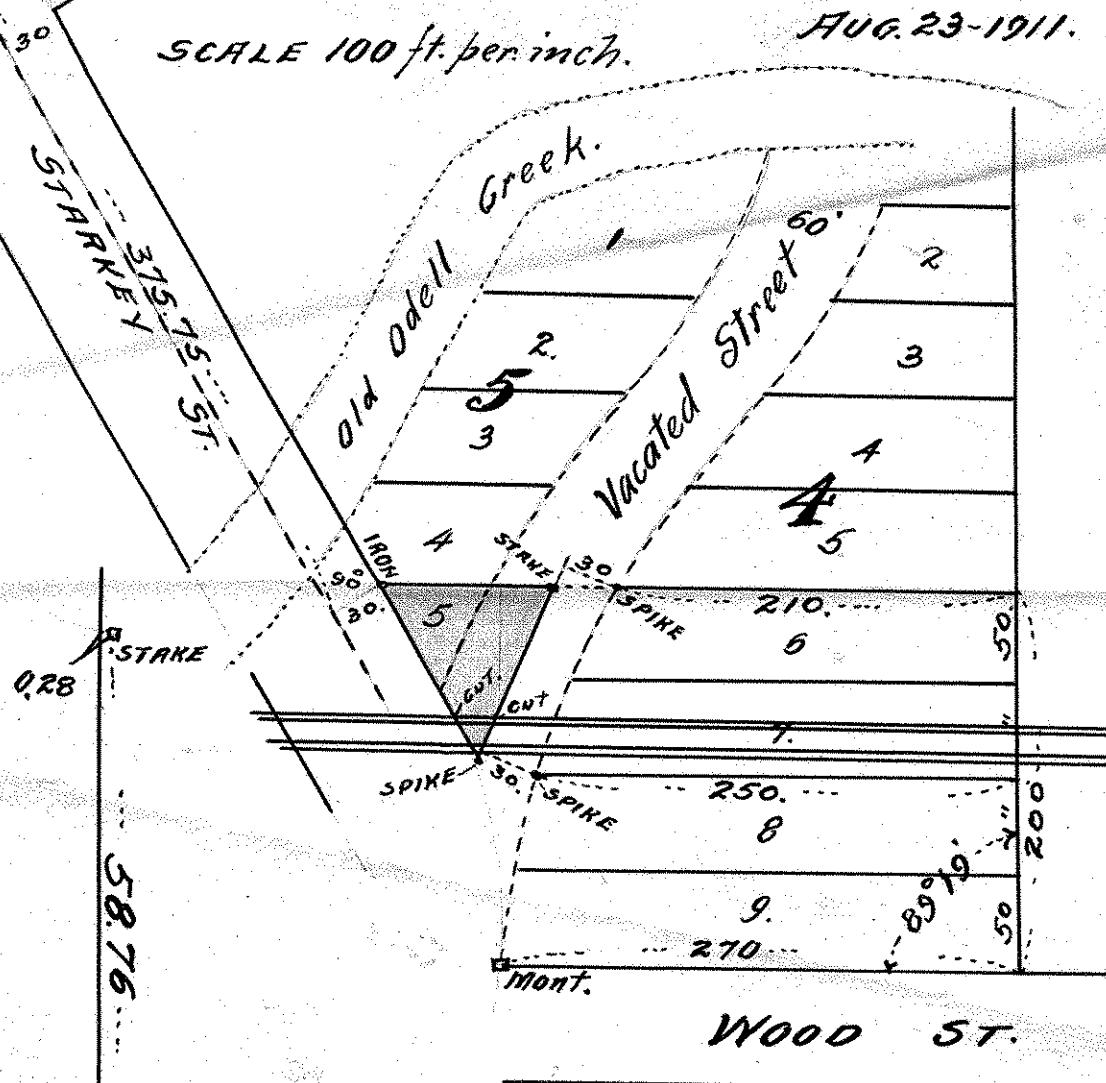

SCALE 20 ft. per inch.

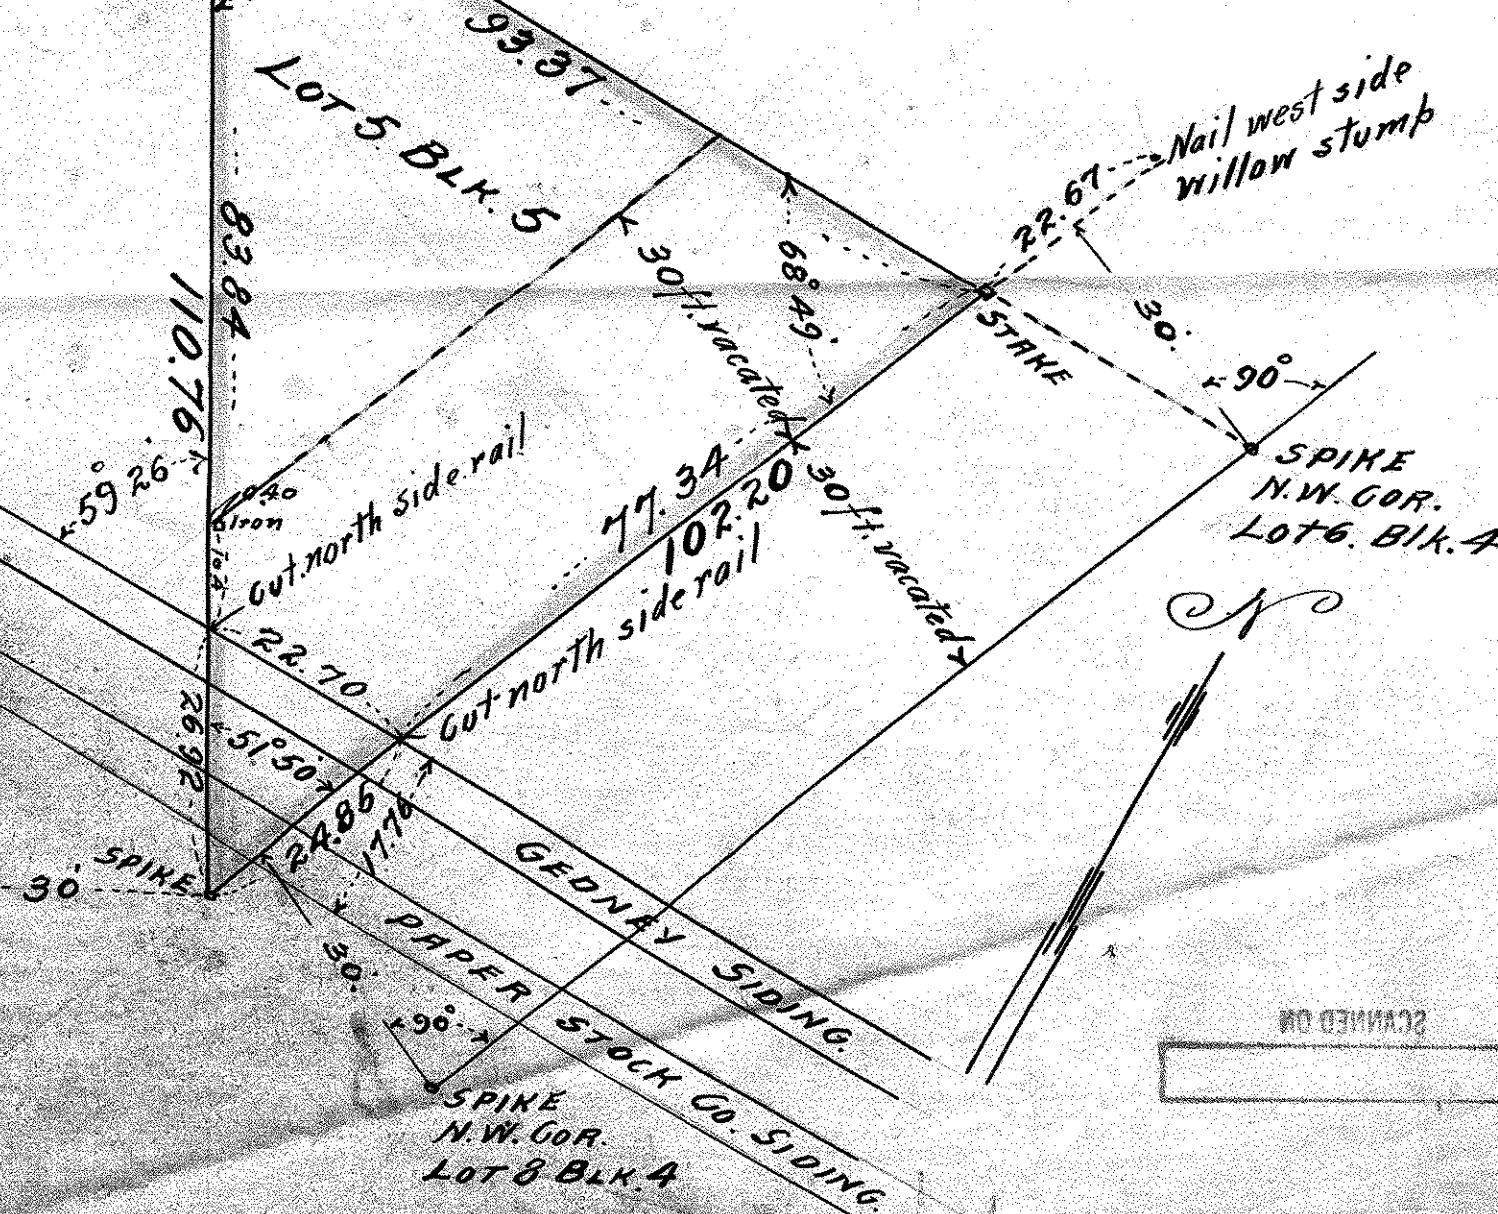

SEARCHED ON