LOTS 1 & 2 BLOCK 28
WEST ST. PAUL PROPER.

JOHN B. IRVINE, SURVEYOR.
408 GLOBE BLD'G.
ST. PAUL, MINN.
FEB 6 - 1912.
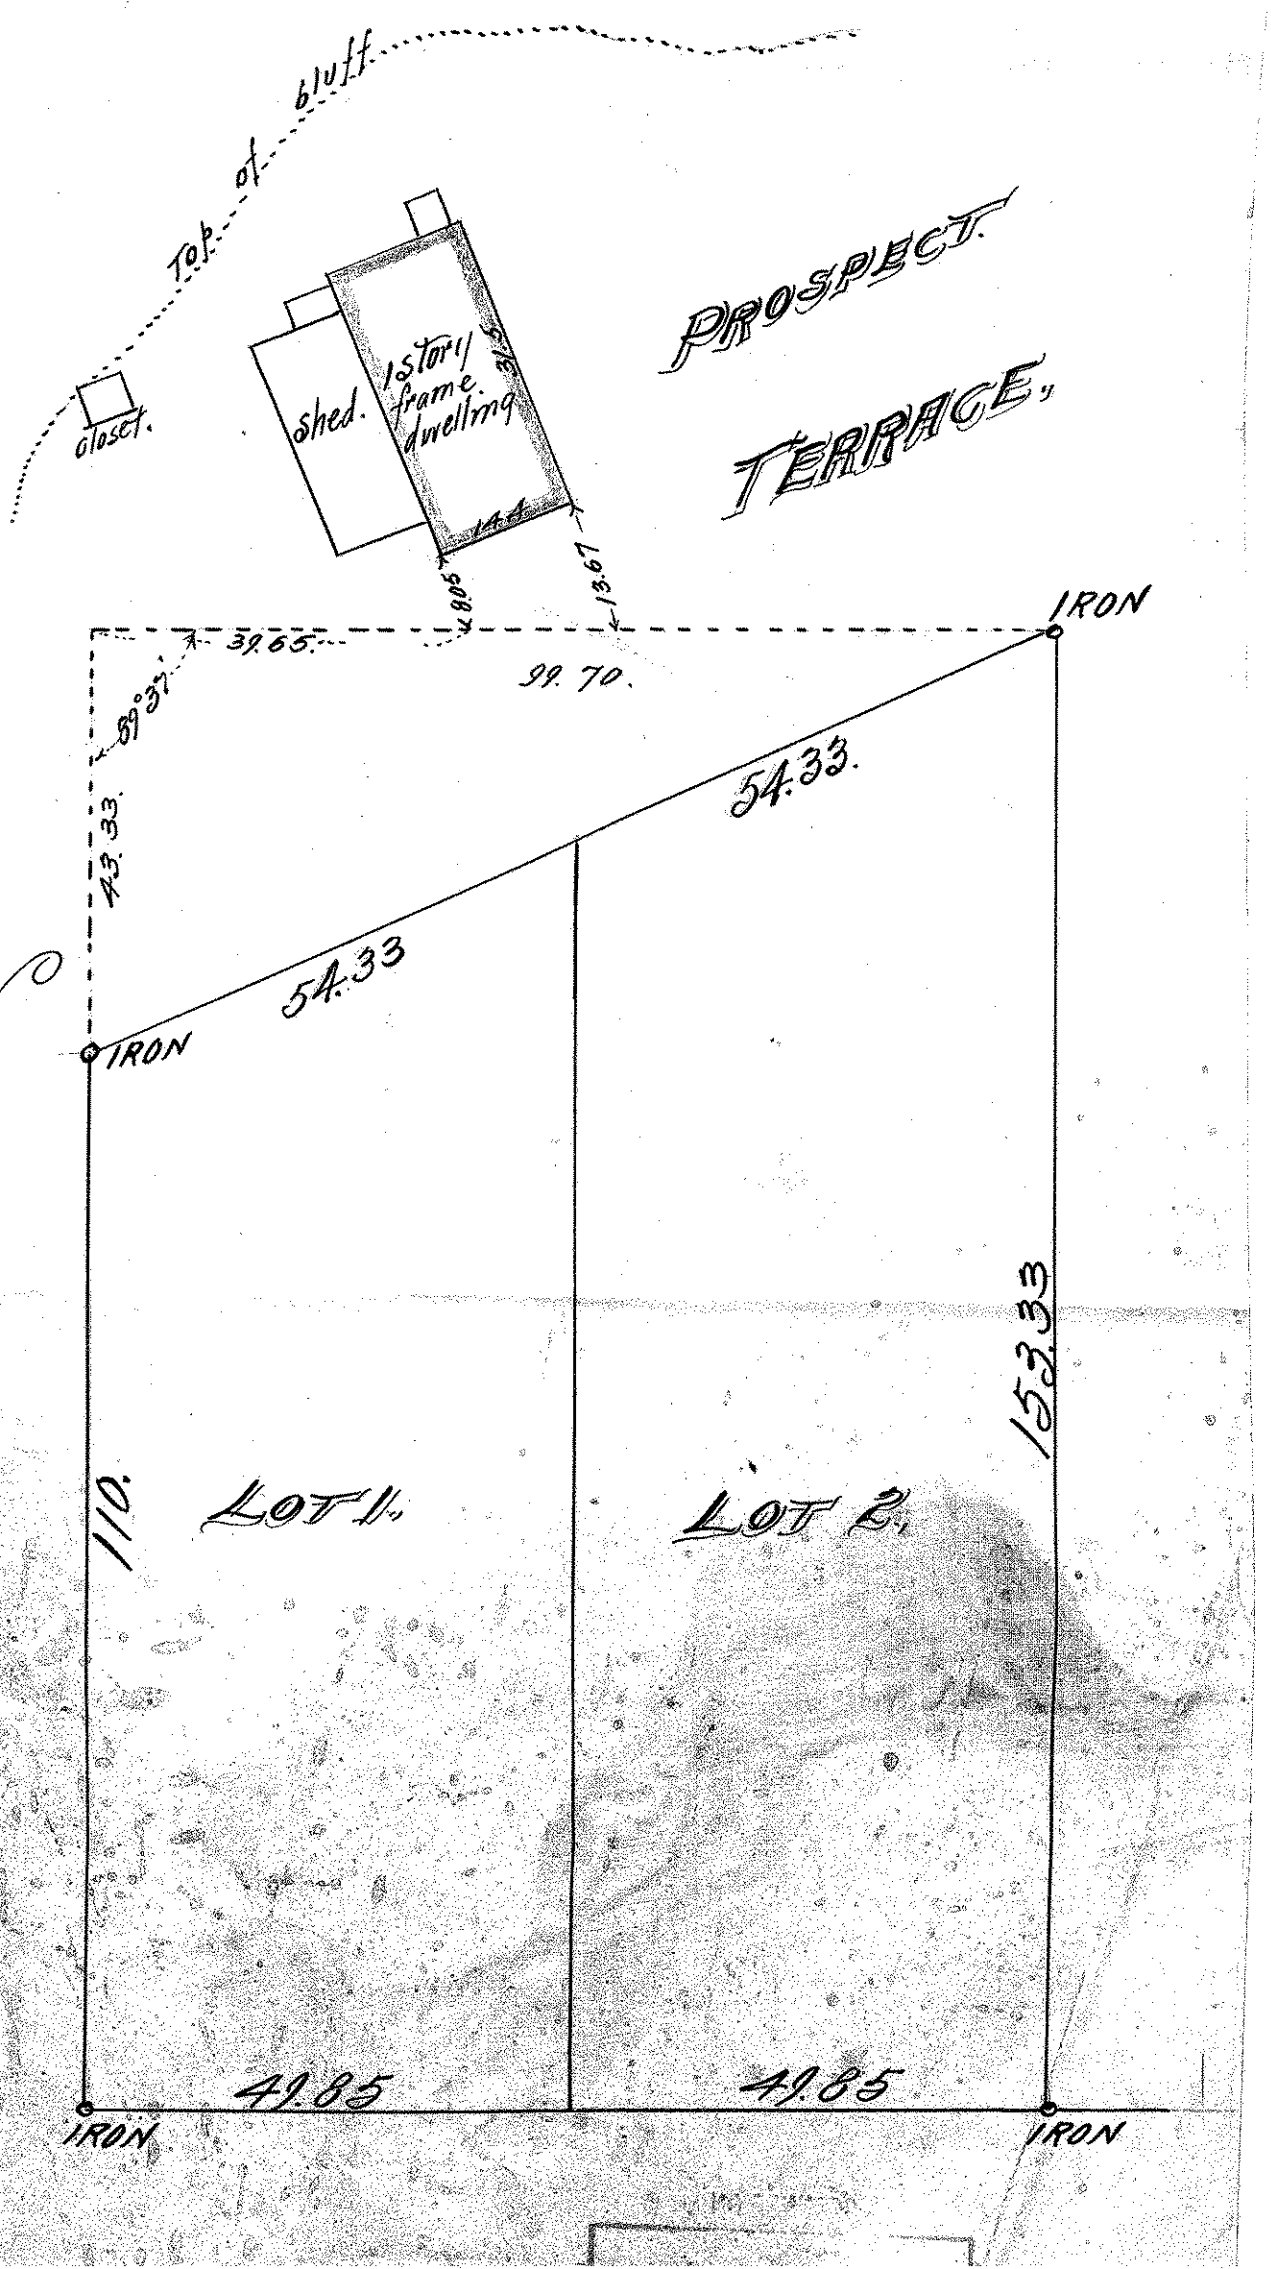
SCALE 20 ft. per. inch.