

LOT 3 BLOCK 28
WEST ST. PAUL PROPER

JOHN. B. IRVINE, SURVEYOR.

408 GLOBE BLDG.

ST. PAUL, MINN.

JUNE 19-1914.


scale 20 ft. per inch.

PROSPECT TERRACE.

BIDWELL ST.

FIVE

WINSLOW

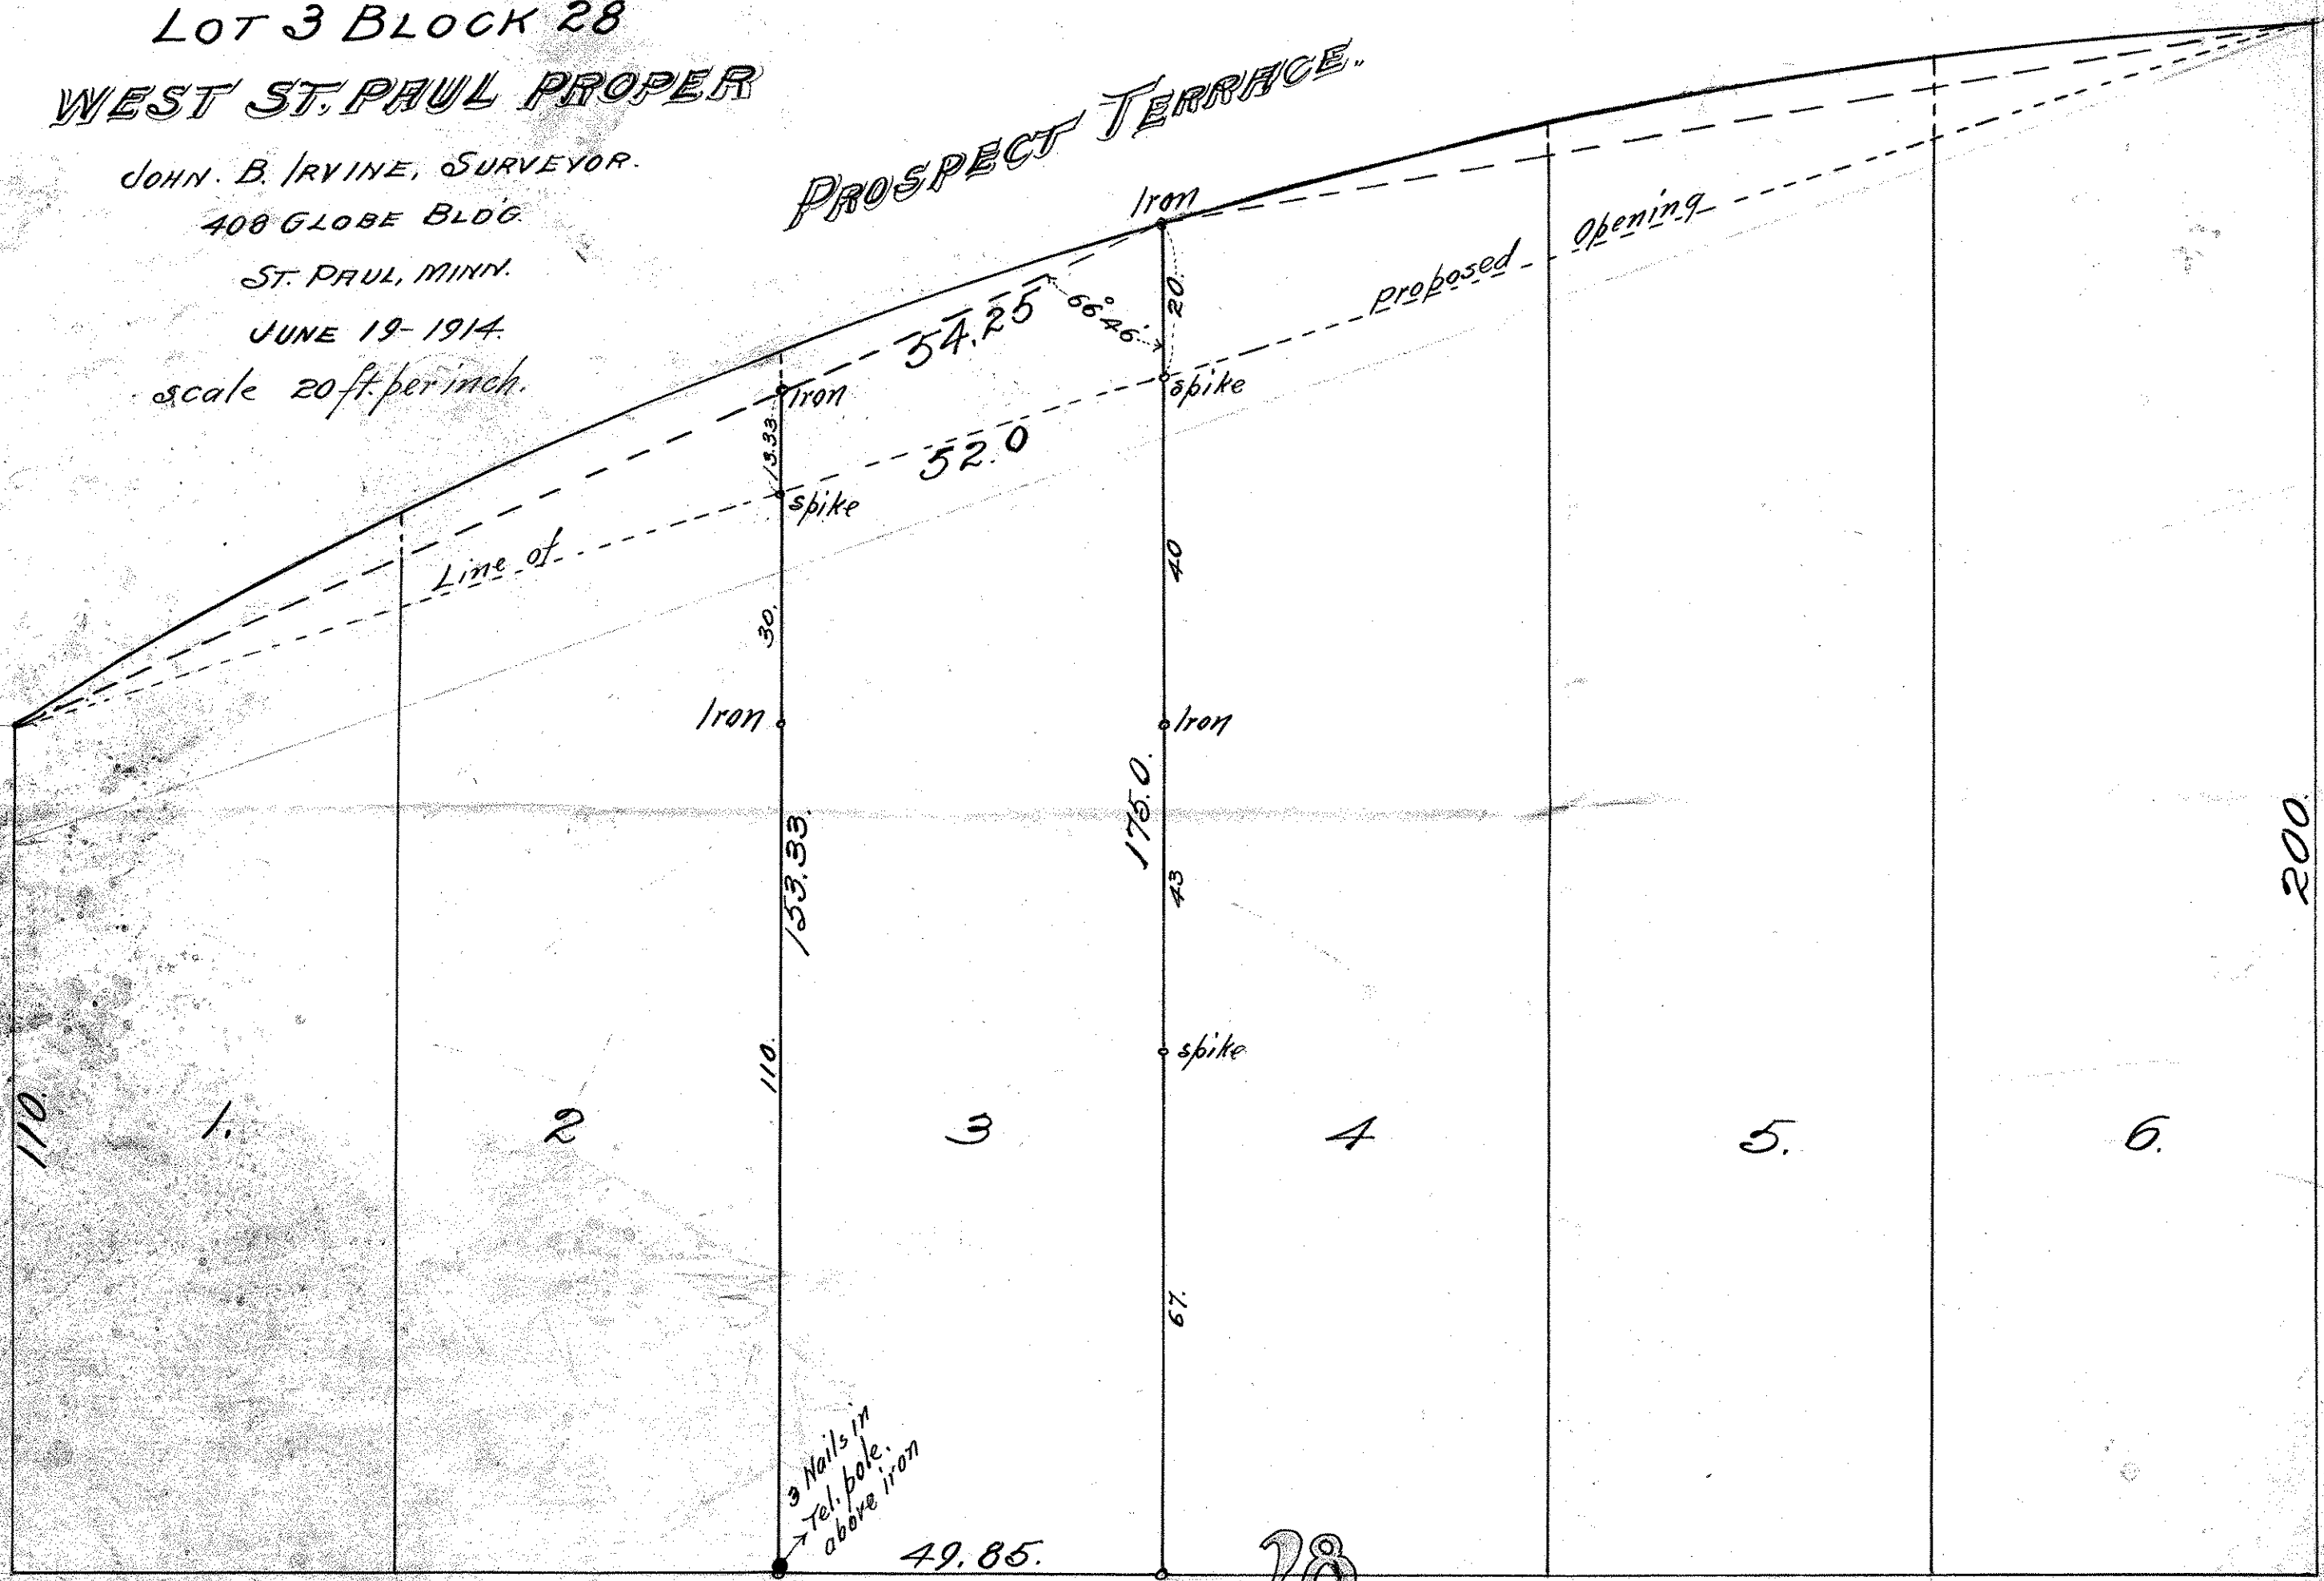

3 Nails in
Tel. pole
above iron

Iron. 2" South of Corner. 49.85.

Iron shed. 20

RECORDED