

LOT 4, BLK. 10.

WEST ST. PAUL PROPER.


JOHN B. IRVINE, SURVEYOR.

ST. PAUL MINN.

Scale 20ft. per inch.

OCT. 15-08.

PROSPECT TERRACE.

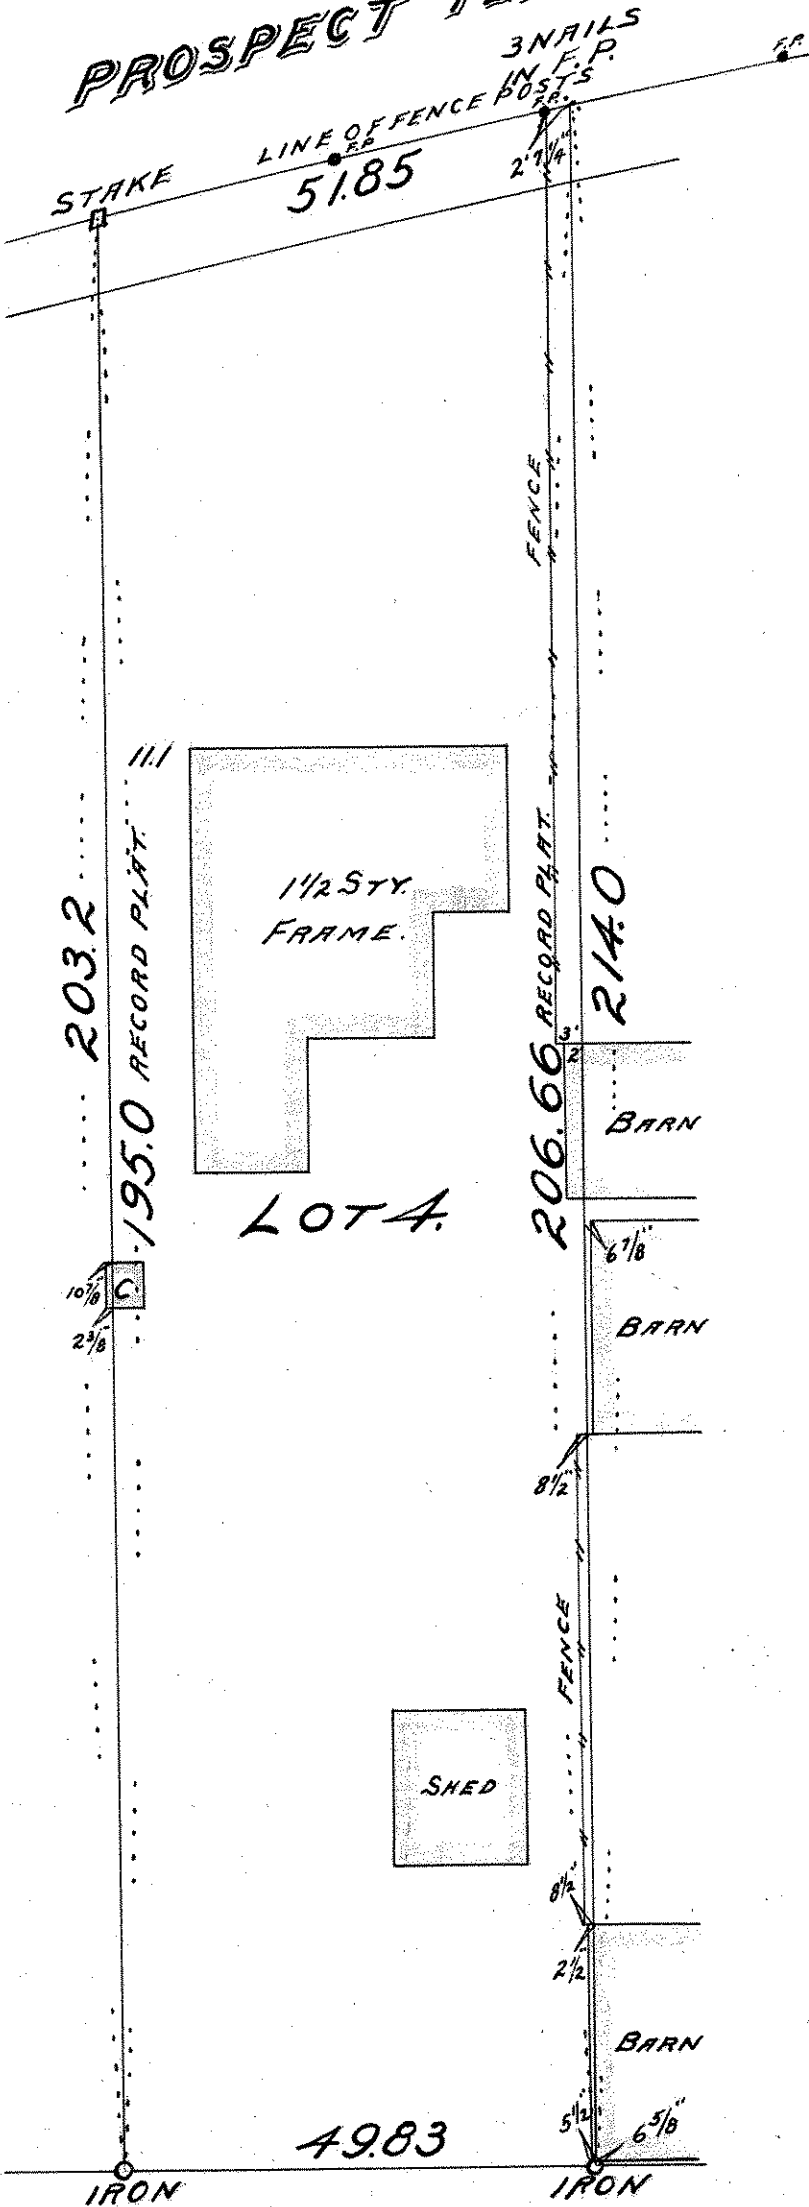

W. COLORADO ST.

