

LOTS 1 & 2 BLOCK 67.
 WEST ST PAUL PROPER.


JOHN B. IRVINE, SURVEYOR.

408 GLOBE BLDG.

ST. PAUL, MINN.

JUNE 11-1914.

CONGRESS ST.

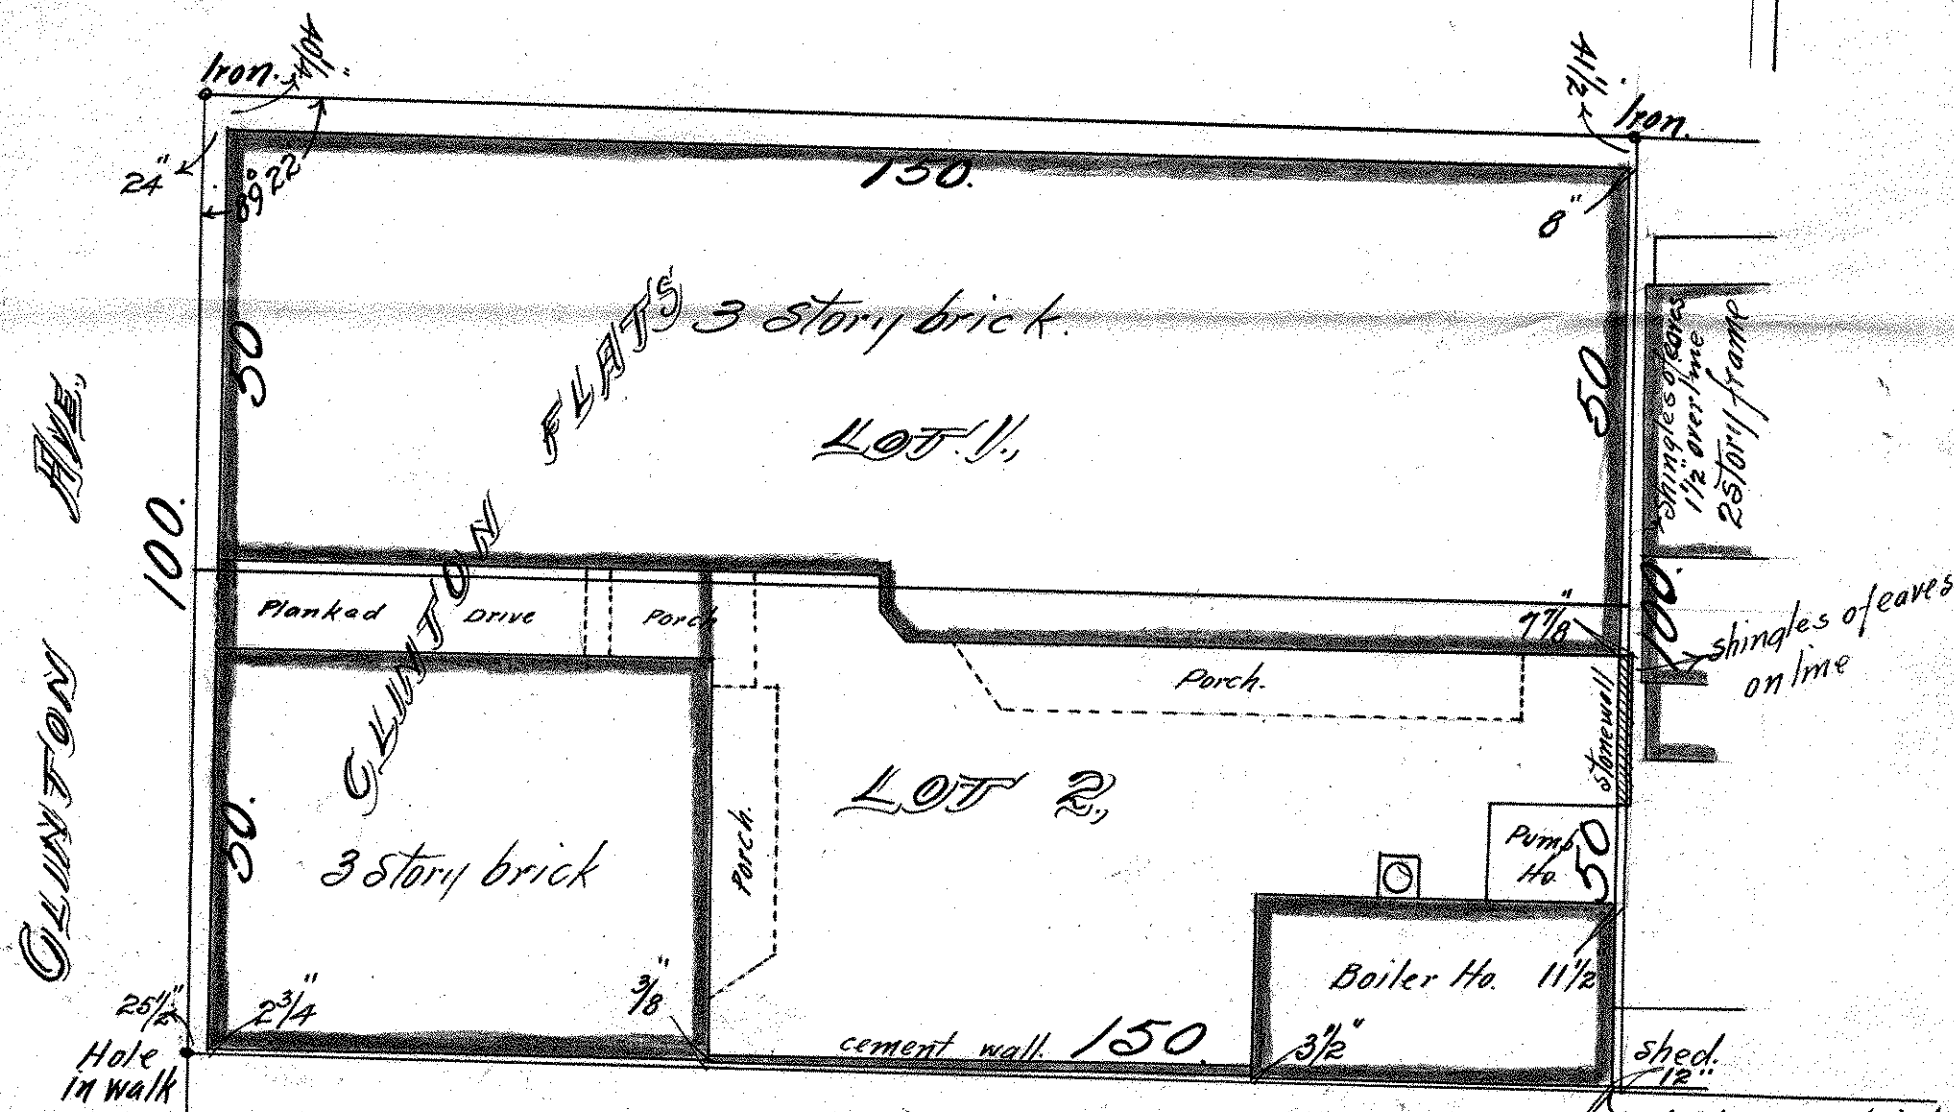

I hereby certify to having surveyed lots 1 & 2 Block 67 West St Paul Proper and located the buildings thereon as shown by this plat and the same is correct.

June 11-1914.

John B. Irvine Surveyor.