



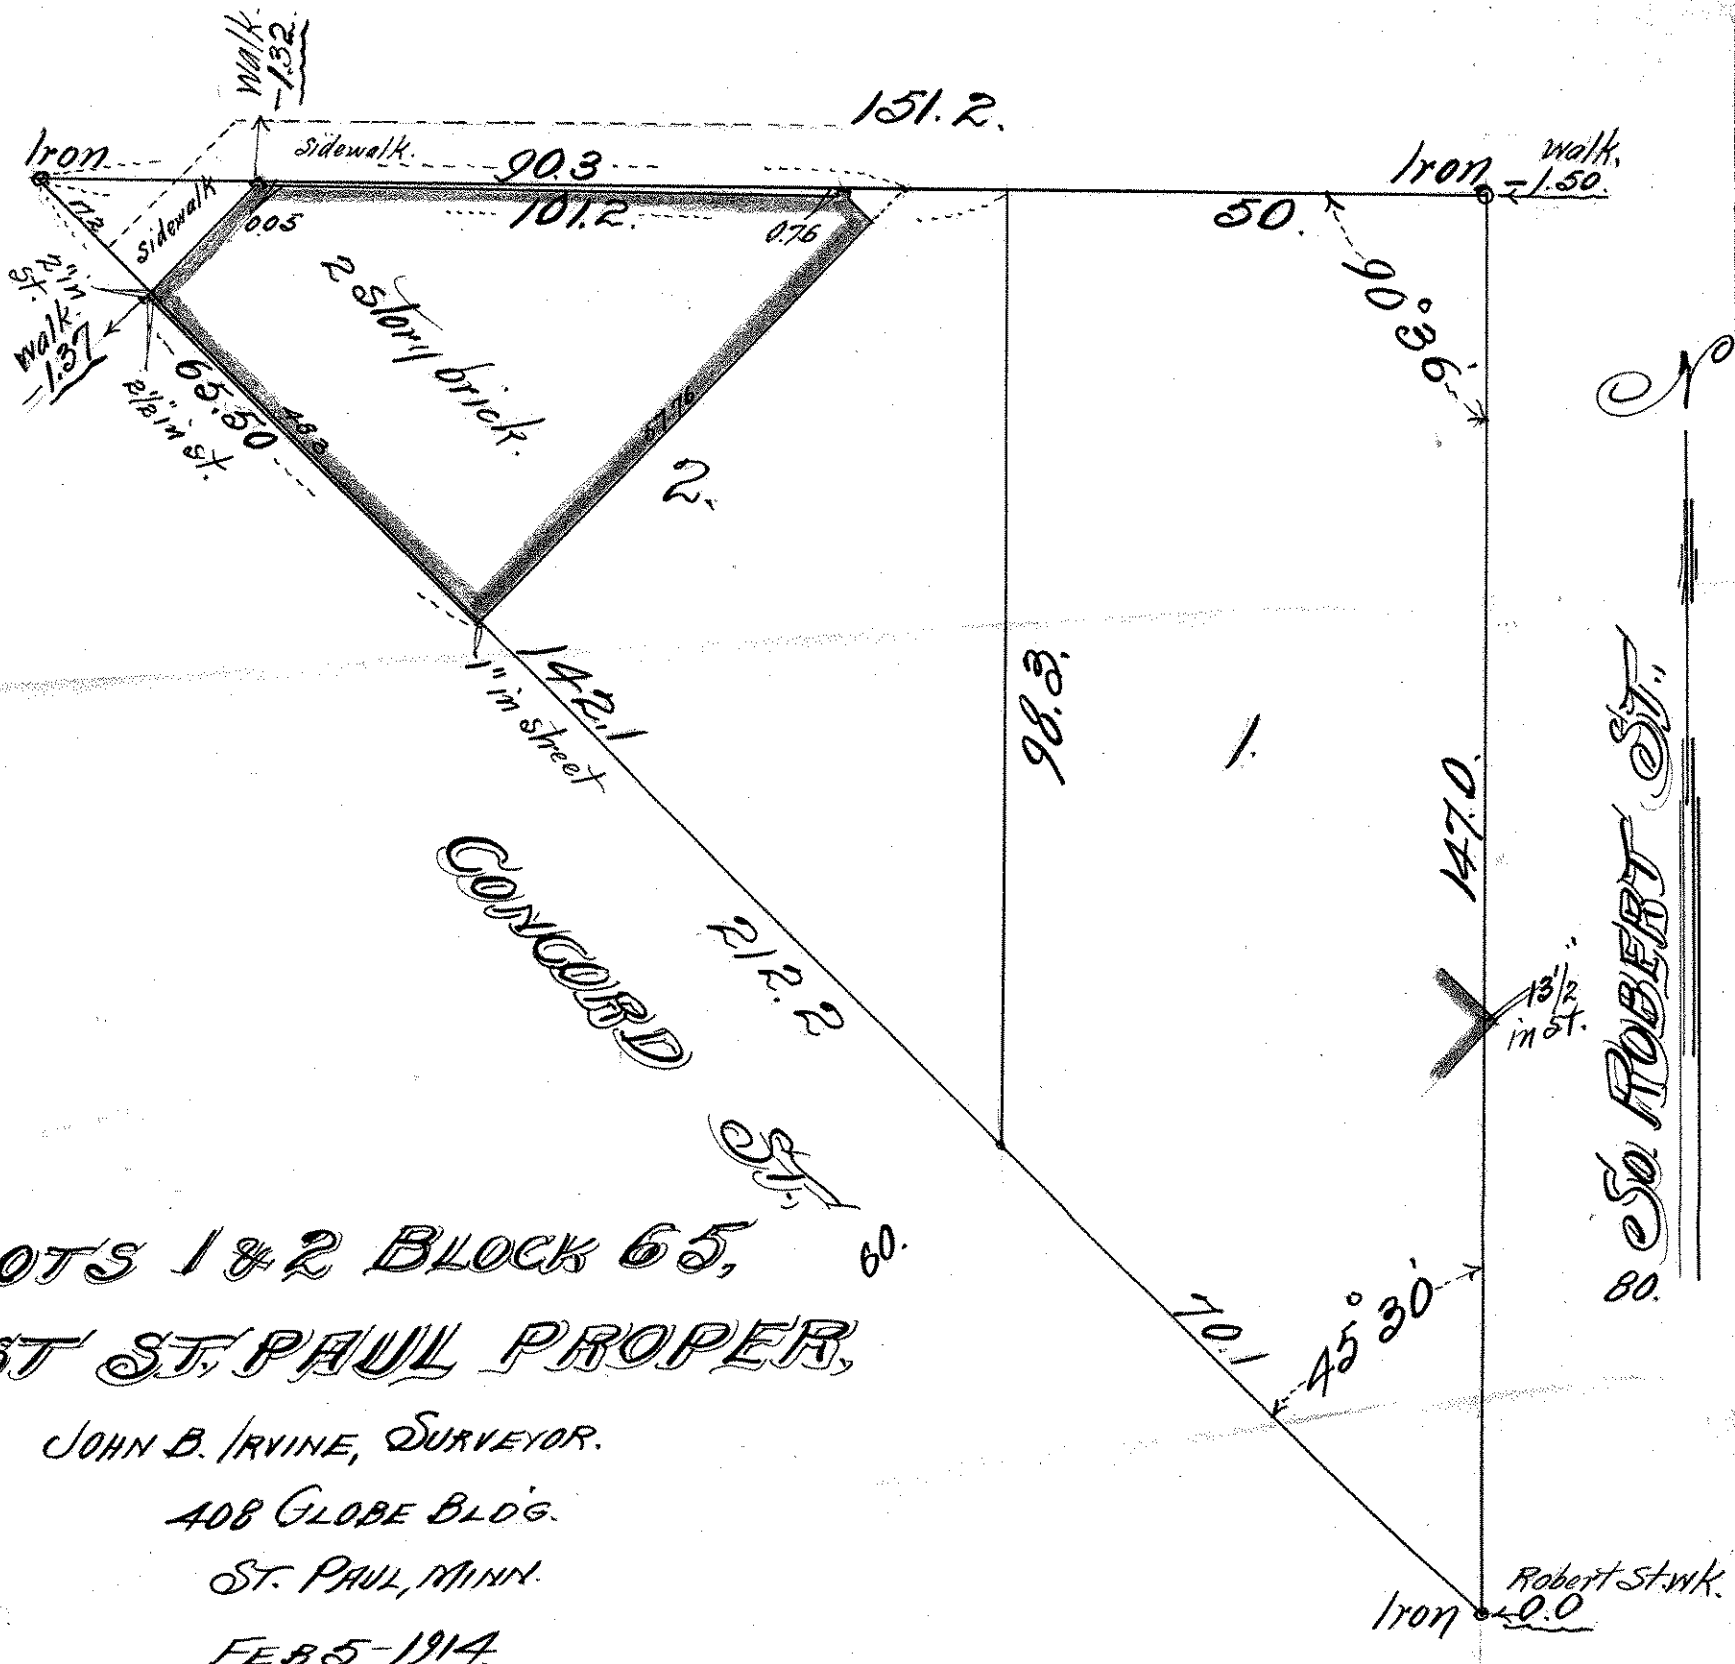

LOTS 1 & 2 BLOCK 65,
WEST ST. PAUL PROPER,

JOHN B. IRVINE, SURVEYOR.

408 GLOBE BLDG.

ST. PAUL, MINN.

FEB. 5-1914

scale. 20 ft. per. inch.

"NOTE"

Figures underlined = Elevations below 0.0.