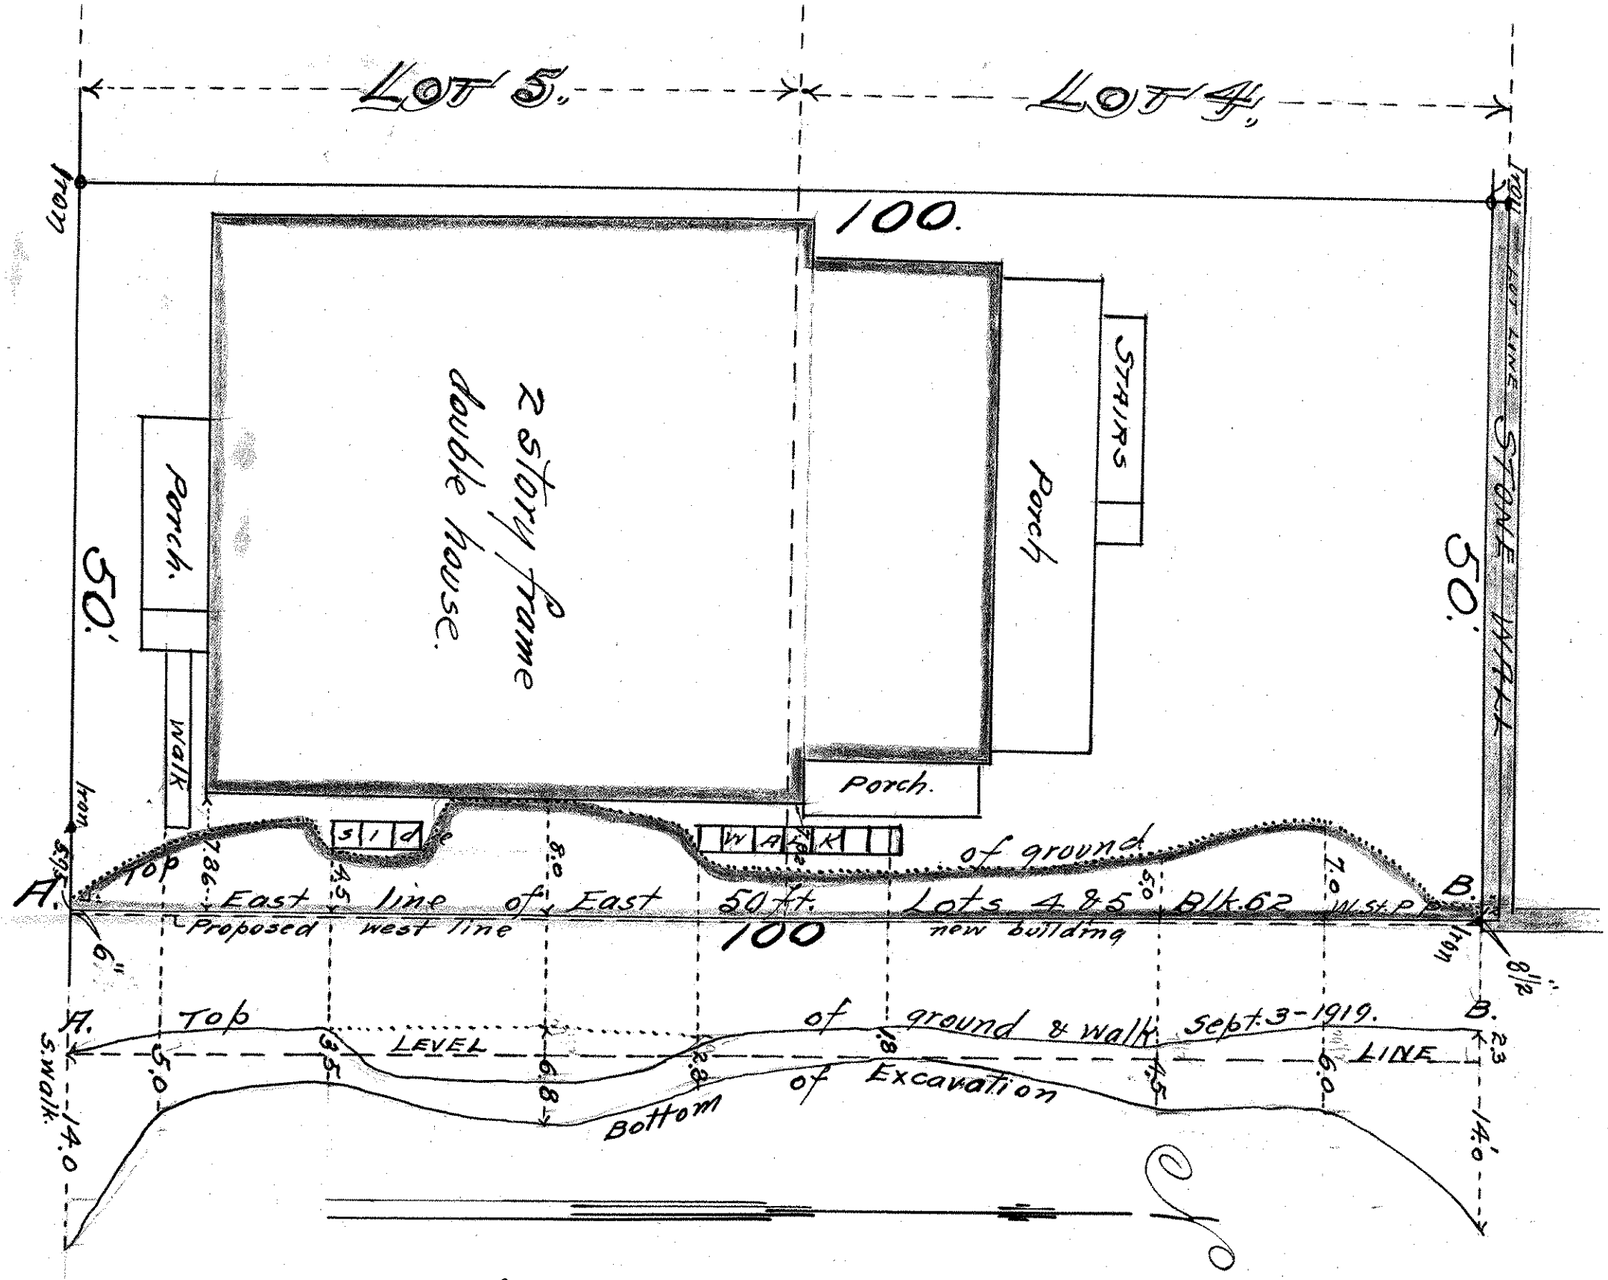

EAST 50 ft. LOTS 4 & 5 BLOCK 62.

WEST ST. PAUL PROPER.

John B. Irvine Surveyor.

St. Paul. Minn.

Sept. 3-1919.

Scale. 10 ft. per. inch.