

NORTH 45 FT. OF LOTS 1, 2, & 3.

BLOCK 54.

WEST ST. PAUL PROPER

JOHN B. IRVINE, SURVEYOR.


ROOM 406 GLOBE BLDG.

ST. PAUL MINN.

SCALE 1 IN. = 20 FT.

JAN. 12. - 06.

88 GOFF AVE.

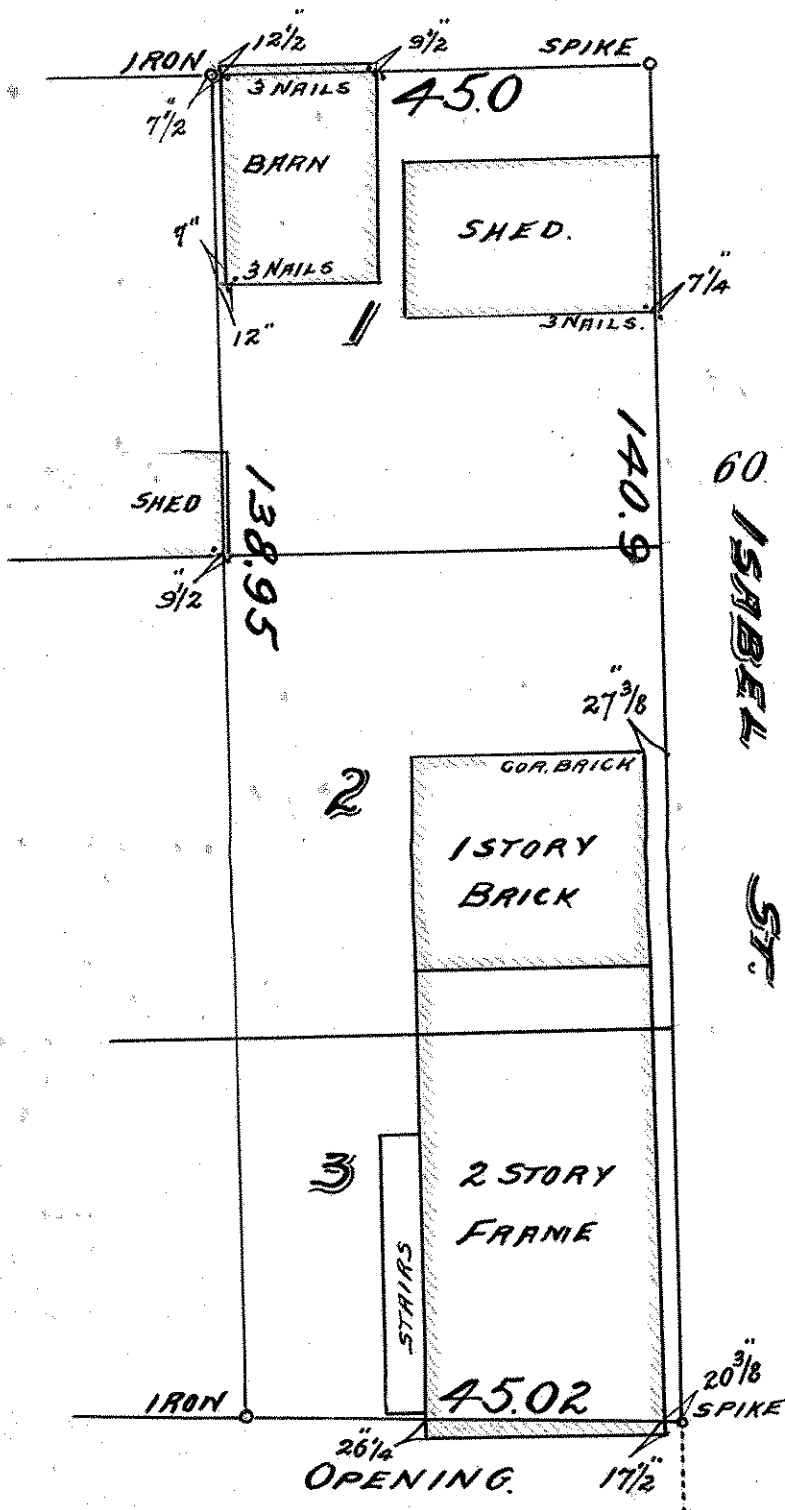

50 SO. WABASHA ST.