


LOT 9 BLK. 54 WEST ST. PAUL PROPER  
 SUR. MAY 20<sup>th</sup> 1903

ISABEL ST  
 AN. Drewry  
 704 Payne av.

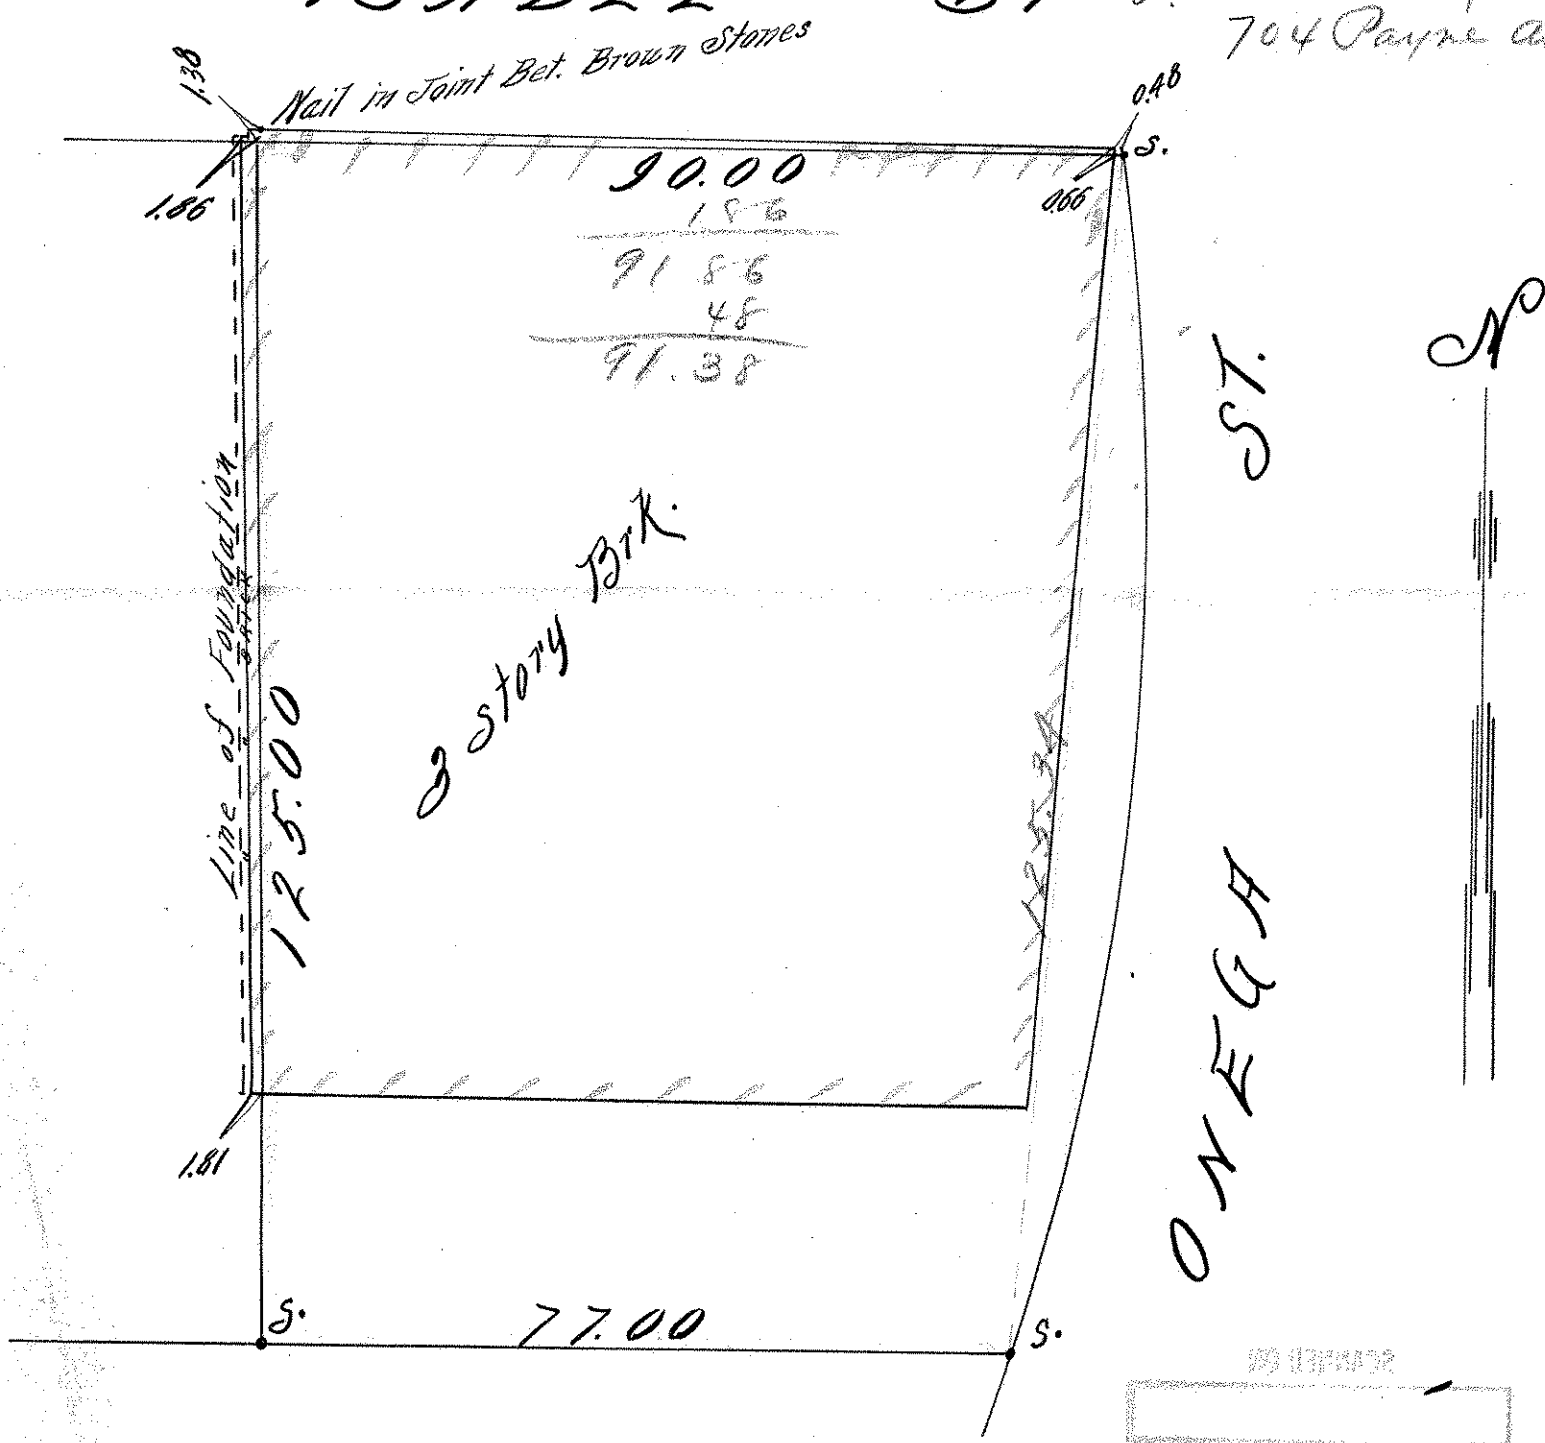

90.00  
 1.86  
 ---  
 91.86  
 48  
 ---  
 91.38

189 1137827