



PART OF LOT 4 BLOCK 53  
WEST ST. PAUL PROPER.

JOHN B. IRVINE, SURVEYOR.

ST. PAUL, MINN.

DEC. 1-1917.

Scale. 20ft. per inch.

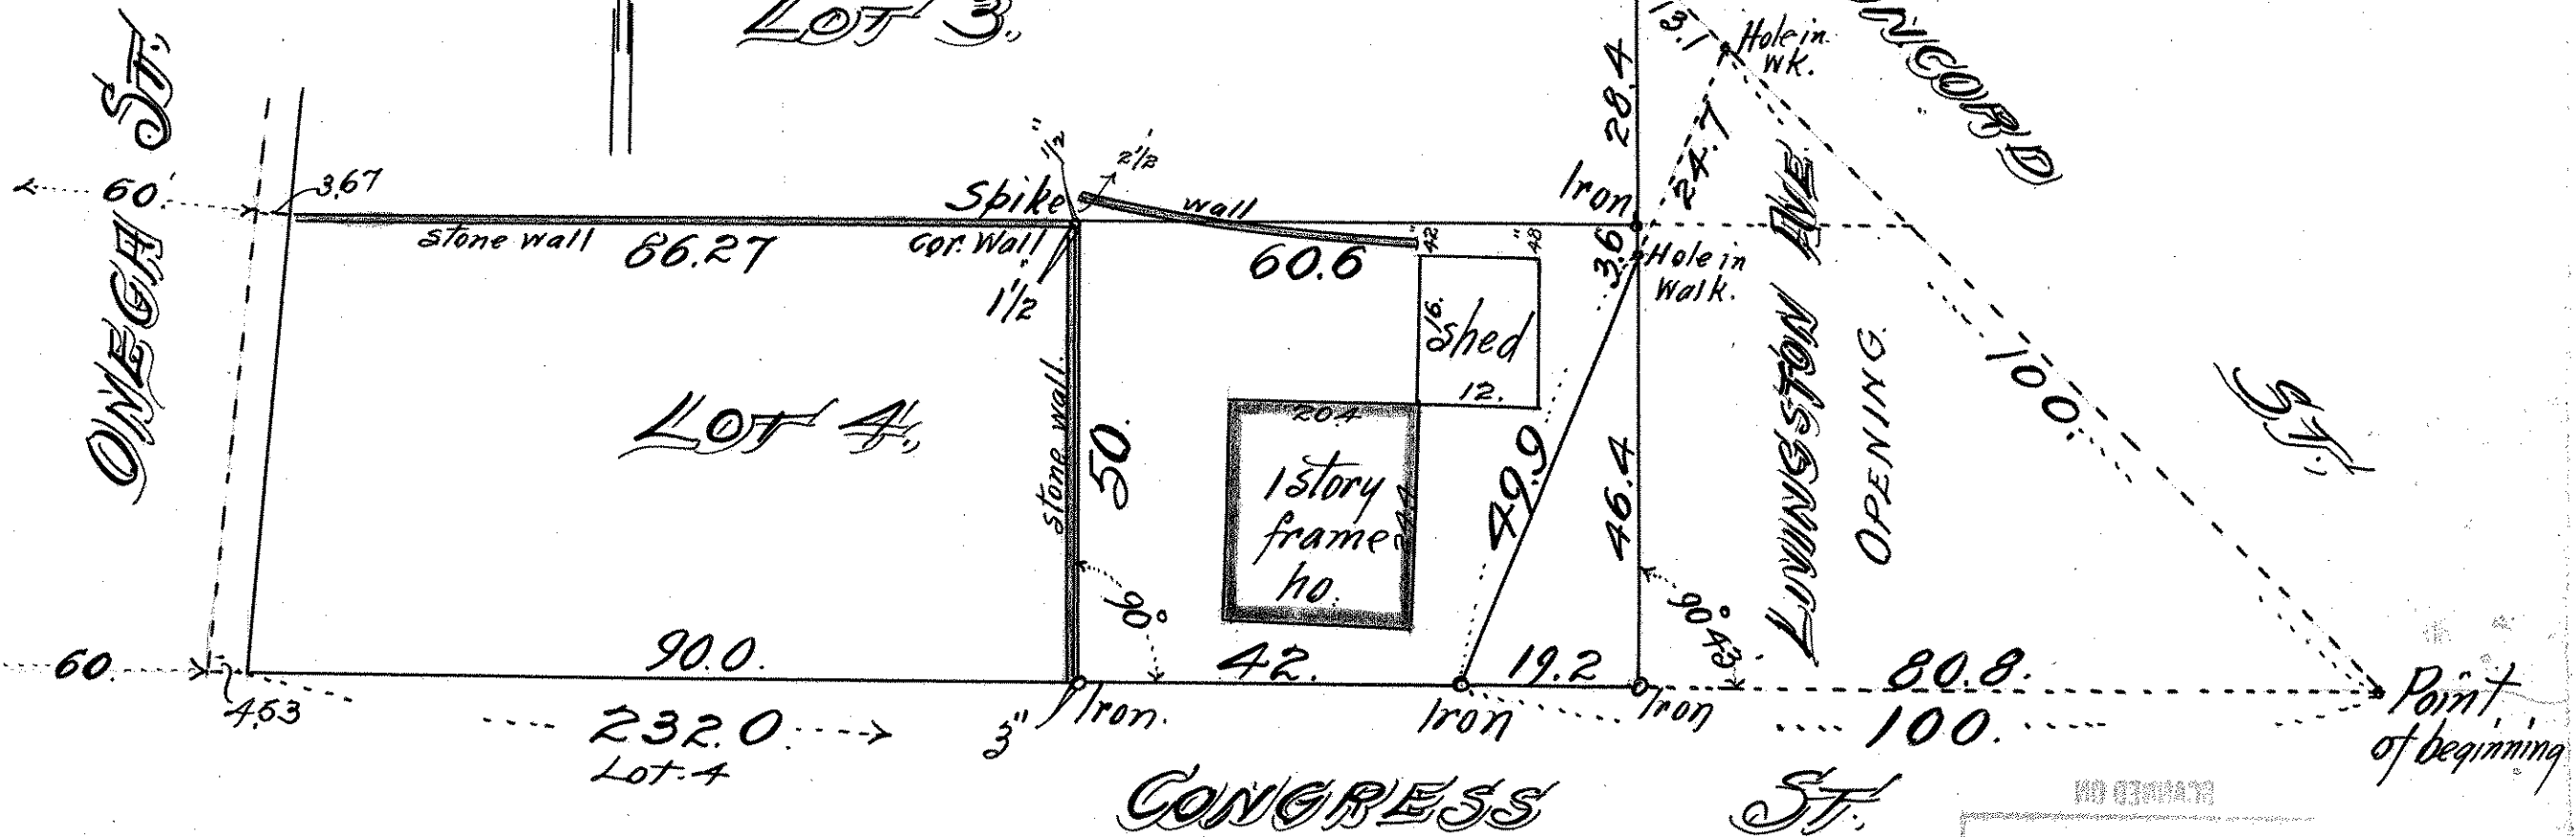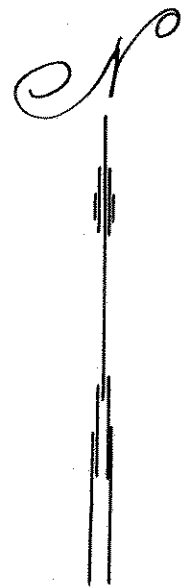

PLANNED BY