"Note { Water line Winifred St. sewer inlet into Concord main = −11 ft. 8½ in.
Top of Manhole Center Winifred & Concord = 0 " 0 "

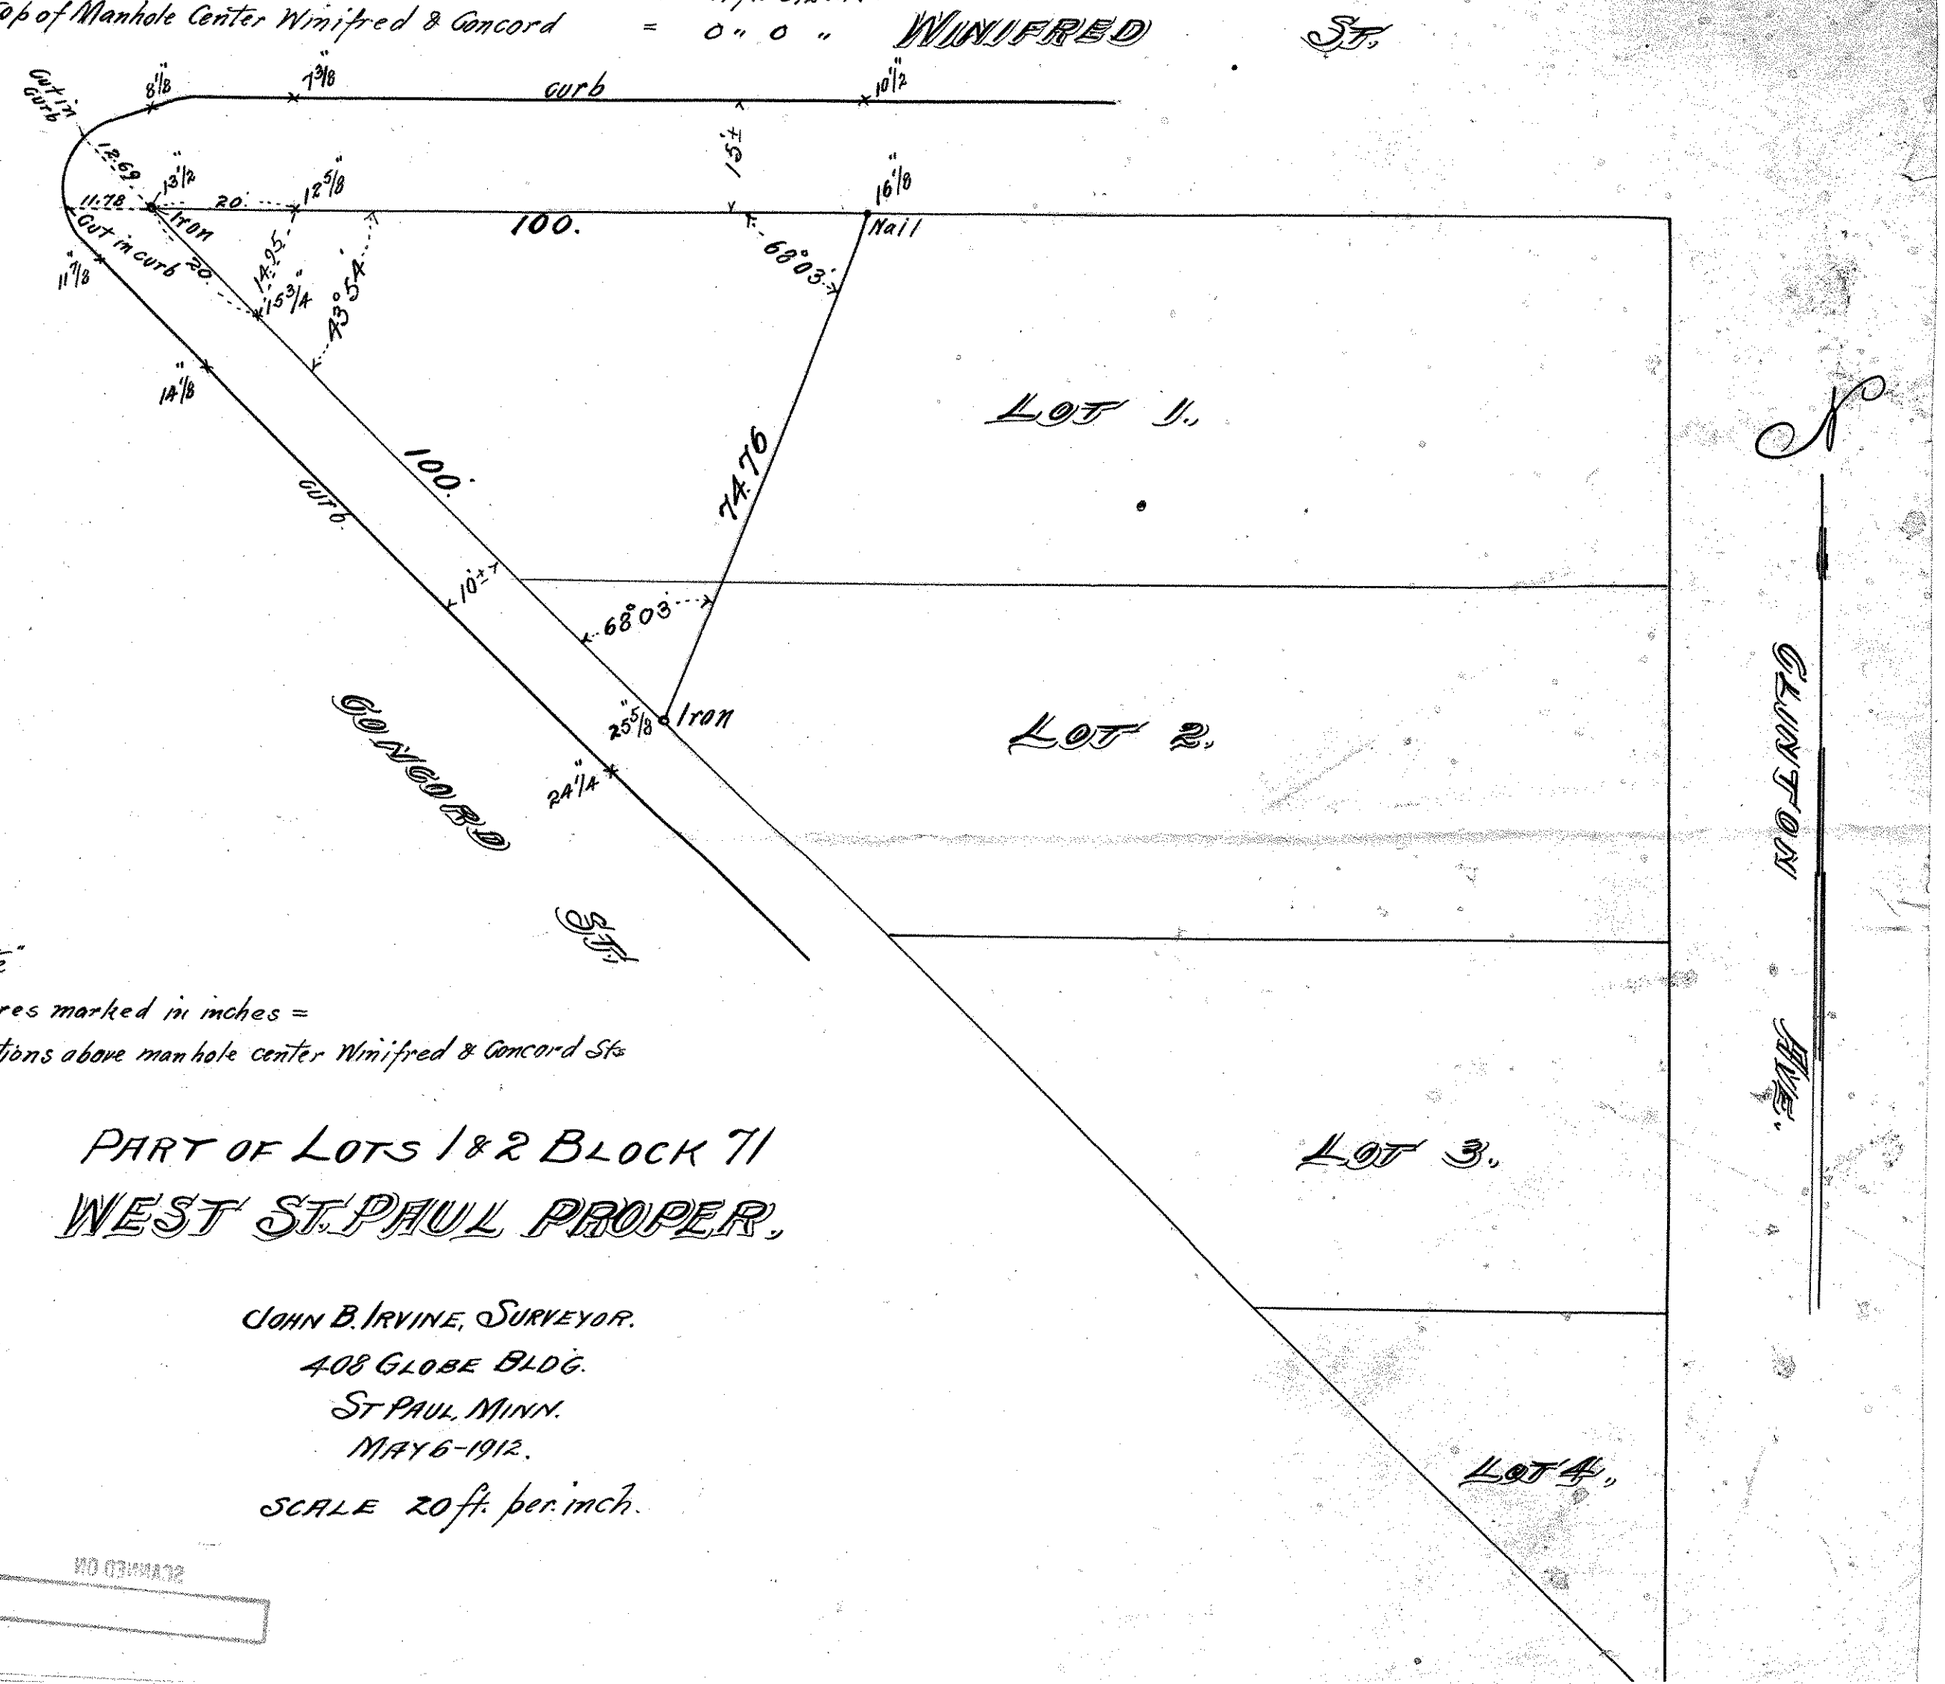

"Note"
Figures marked in inches =
Elevations above manhole center Winifred & Concord Sts

PART OF LOTS 1 & 2 BLOCK 71
WEST ST. PAUL PROPER.

JOHN B. IRVINE, SURVEYOR.
408 GLOBE BLDG.
ST PAUL, MINN.
MAY 6-1912.
SCALE 20 ft. per inch.

SCANNED ON